

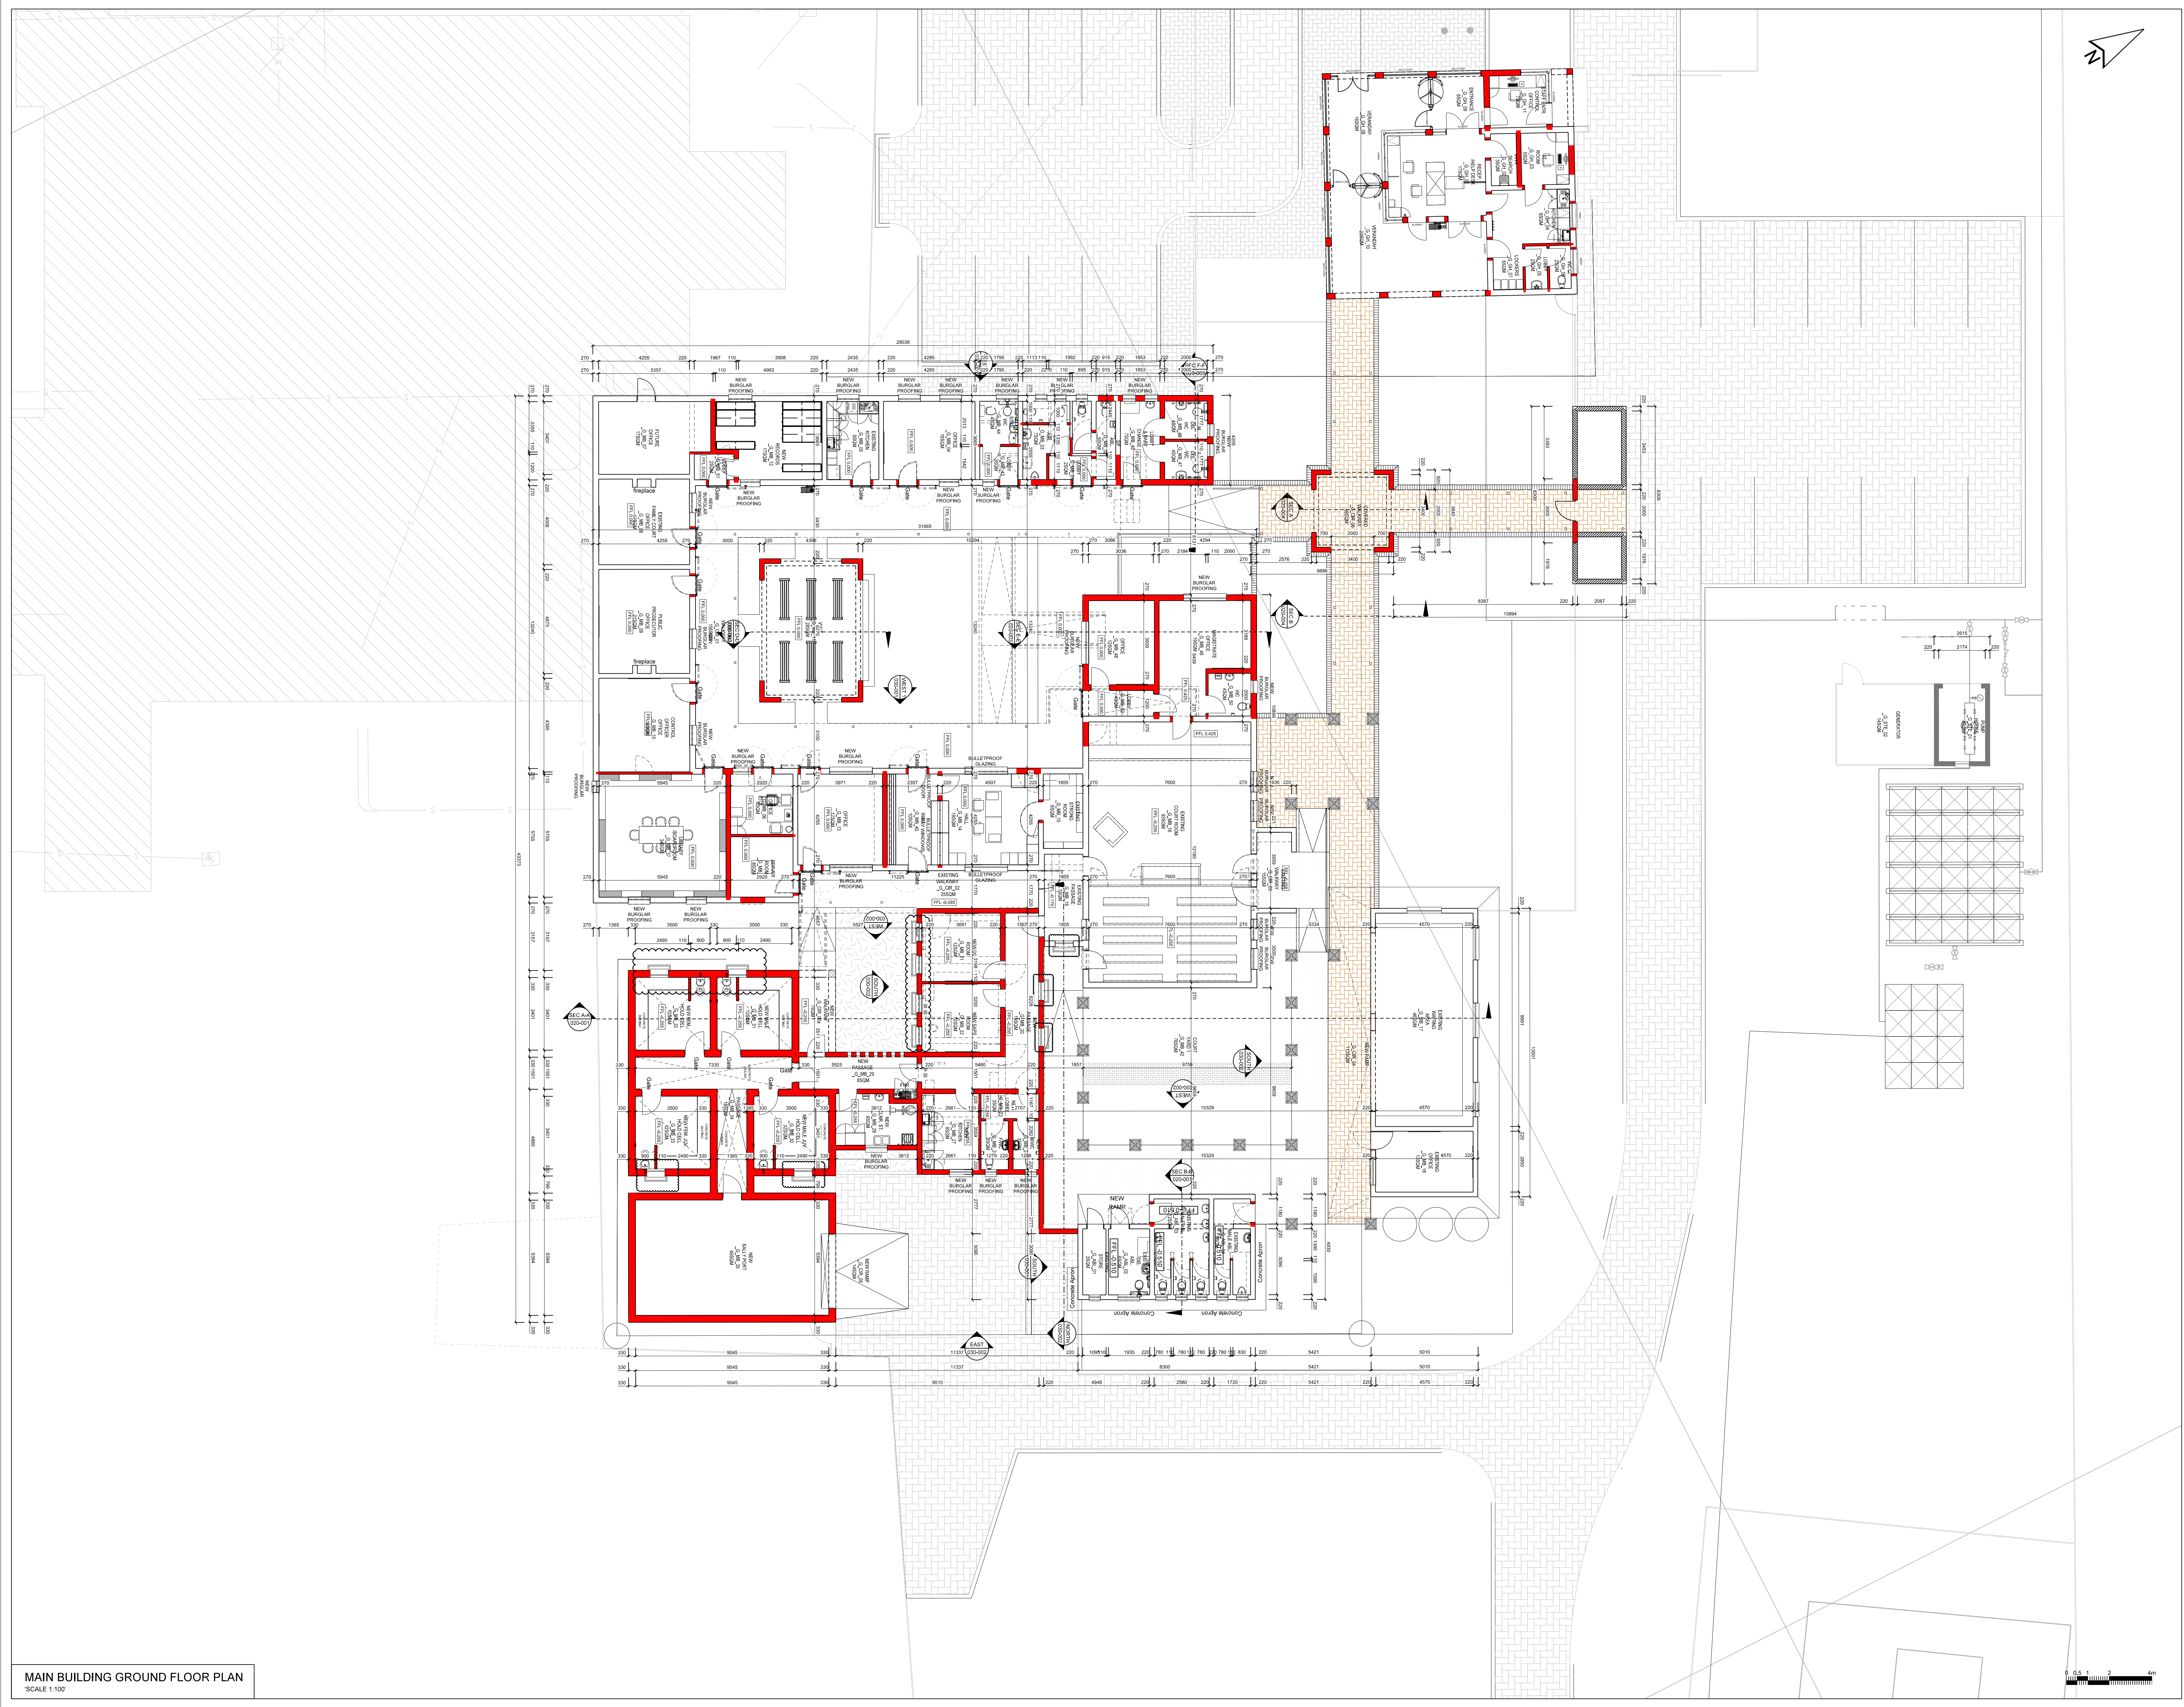
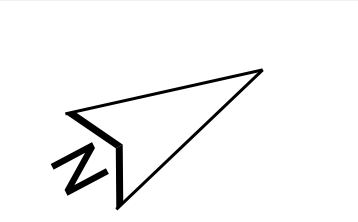
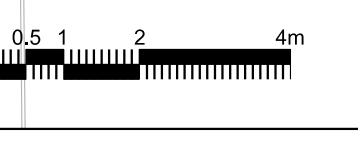


No.	DATE	AMENDMENT	D.P.W.
<small> 100% 2013/03/01 FJAD DETAIL REFERENCES R03 2014-02-11 Kvs/8/ Update Section to match SE Drawings details R03 2021-04-16 BVS/2 Review to include new parking canopy details </small>			
Copyright vests in the Department of Public Works			
as-built drawings			
certified as-built drawings as per Centralised Drawing Archive AS-BUILT DRAWING REQUIREMENTS			
name: _____			
date: _____			
professional registration no.: _____			
cad file name		page type	
25500-010-012 A 0			
 public works Department of Public Works REPUBLIC OF SOUTH AFRICA DIRECTOR-GENERAL MR. NZIWOIKE DLABANTU			
consultant			
 Bartsch BARTSCH CONSULT (Pty) Ltd REG. NO. DK 9178623			
discipline			
ARCHITECT			
service			
SKETCH PLANS			
BERGVILLE JUSTICE - COMPLETE UPGRADING INCLUDING R & R			
WCS number		WCS 036745	
drawing title			
CANOPY ROOF PLAN, DETAILS AND SECTION			
ref. no.	designed		
scale	AS SHOWN	drawn	BVS
date	16-Apr-21	checked	
DPW drawing number			
25500-010-012		R03 16-Apr-21	



MAIN BUILDING GROUND FLOOR PLAN
SCALE 1:100

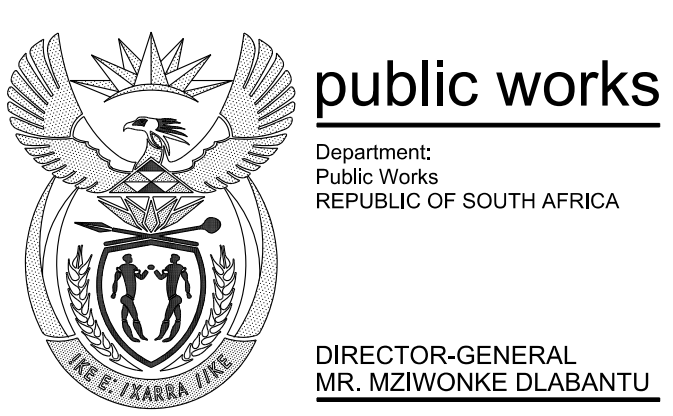

No.	DATE	AMENDMENT	D.P.W.
R08	2013/03/11	F20: Add window to cleaner store. Add glass blocks to sanitary 105/MS20	
R07	2013/03/11	F20: CORRECTED PRISON TYPE WINDOWS ON NEW BUILDING. REVERSED SALLY PORT LEVELS.	
R06	2013/03/11	F20: CORRECTED PRISON TYPE WINDOWS ON NEW BUILDING. REVERSED SALLY PORT LEVELS. AND 2013/03/11: F20: CORRECTED PRISON TYPE WINDOWS ON NEW BUILDING. REVERSED SALLY PORT LEVELS. CHANGE ROOMS TO OFFICE AND OFFICE IN PROGRESS.	
R05	2013/03/11	F20: CORRECTED PRISON TYPE WINDOWS ON NEW BUILDING. REVERSED SALLY PORT LEVELS. CHANGE ROOMS TO OFFICE AND OFFICE IN PROGRESS. CHANGE ROOMS TO OFFICE AND OFFICE IN PROGRESS. CHANGE ROOMS TO OFFICE AND OFFICE IN PROGRESS.	
R04	2013/03/11	F20: CORRECTED PRISON TYPE WINDOWS ON NEW BUILDING. REVERSED SALLY PORT LEVELS. CHANGE ROOMS TO OFFICE AND OFFICE IN PROGRESS. CHANGE ROOMS TO OFFICE AND OFFICE IN PROGRESS. CHANGE ROOMS TO OFFICE AND OFFICE IN PROGRESS.	
R03	2013/03/11	F20: CORRECTED PRISON TYPE WINDOWS ON NEW BUILDING. REVERSED SALLY PORT LEVELS. CHANGE ROOMS TO OFFICE AND OFFICE IN PROGRESS. CHANGE ROOMS TO OFFICE AND OFFICE IN PROGRESS. CHANGE ROOMS TO OFFICE AND OFFICE IN PROGRESS.	
R02	2013/03/11	F20: CORRECTED PRISON TYPE WINDOWS ON NEW BUILDING. REVERSED SALLY PORT LEVELS. CHANGE ROOMS TO OFFICE AND OFFICE IN PROGRESS. CHANGE ROOMS TO OFFICE AND OFFICE IN PROGRESS. CHANGE ROOMS TO OFFICE AND OFFICE IN PROGRESS.	
R01	2013/03/11	F20: CORRECTED PRISON TYPE WINDOWS ON NEW BUILDING. REVERSED SALLY PORT LEVELS. CHANGE ROOMS TO OFFICE AND OFFICE IN PROGRESS. CHANGE ROOMS TO OFFICE AND OFFICE IN PROGRESS. CHANGE ROOMS TO OFFICE AND OFFICE IN PROGRESS.	

Copyright vests in the Department of Public Works as-built drawings
certified as-built drawings as per Centralised Drawing Archive AS-BUILT DRAWING REQUIREMENTS
name: _____
date: _____
professional registration no.: _____







cad file name: 25500-010-013 page type: A 0



consultant: **Bartsch** KPM016
BARTSCH CONSULT (Pty) Ltd
REG. NO. DK 6078603
HARRISBURGH: TEL: 051 862 2471, P.O. BOX 762, HARRISBURGH 8680
DURBAN: TEL: 031 274 1711, DURBAN 4001
EAST LONDON: TEL: 031 274 1711, EAST LONDON 4001
CAPE TOWN: TEL: 021 460 1711, CAPE TOWN 8001
WINDHOEK: TEL: 064 460 1711, WINDHOEK 8001

discipline: ARCHITECT
service: SKETCH PLANS
BERGVILLE JUSTICE - COMPLETE UPGRADING INCLUDING R & R

WCS number: WCS 036745
drawing title: MAIN BUILDING - PLAN
ref.no.: designed
scale: 1:100
date: 22-Apr-21
DWI drawing number: 25500-010-013
checked: EWS
checked: R08
22-Apr-21

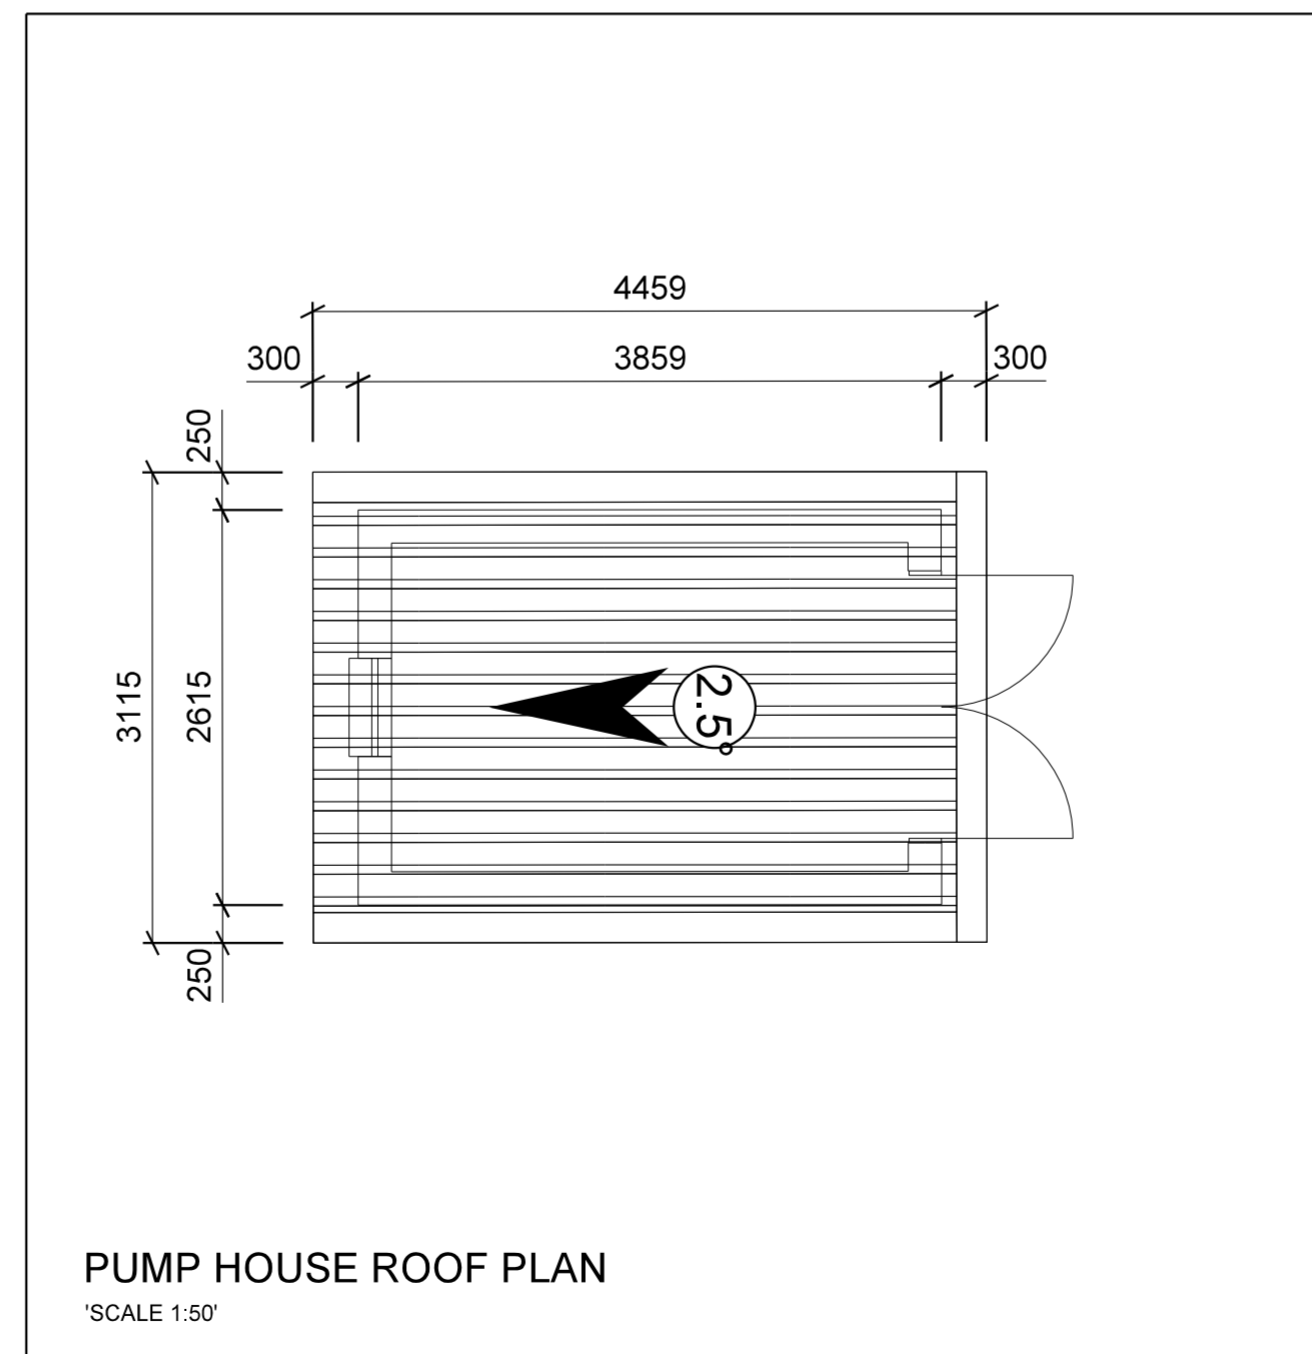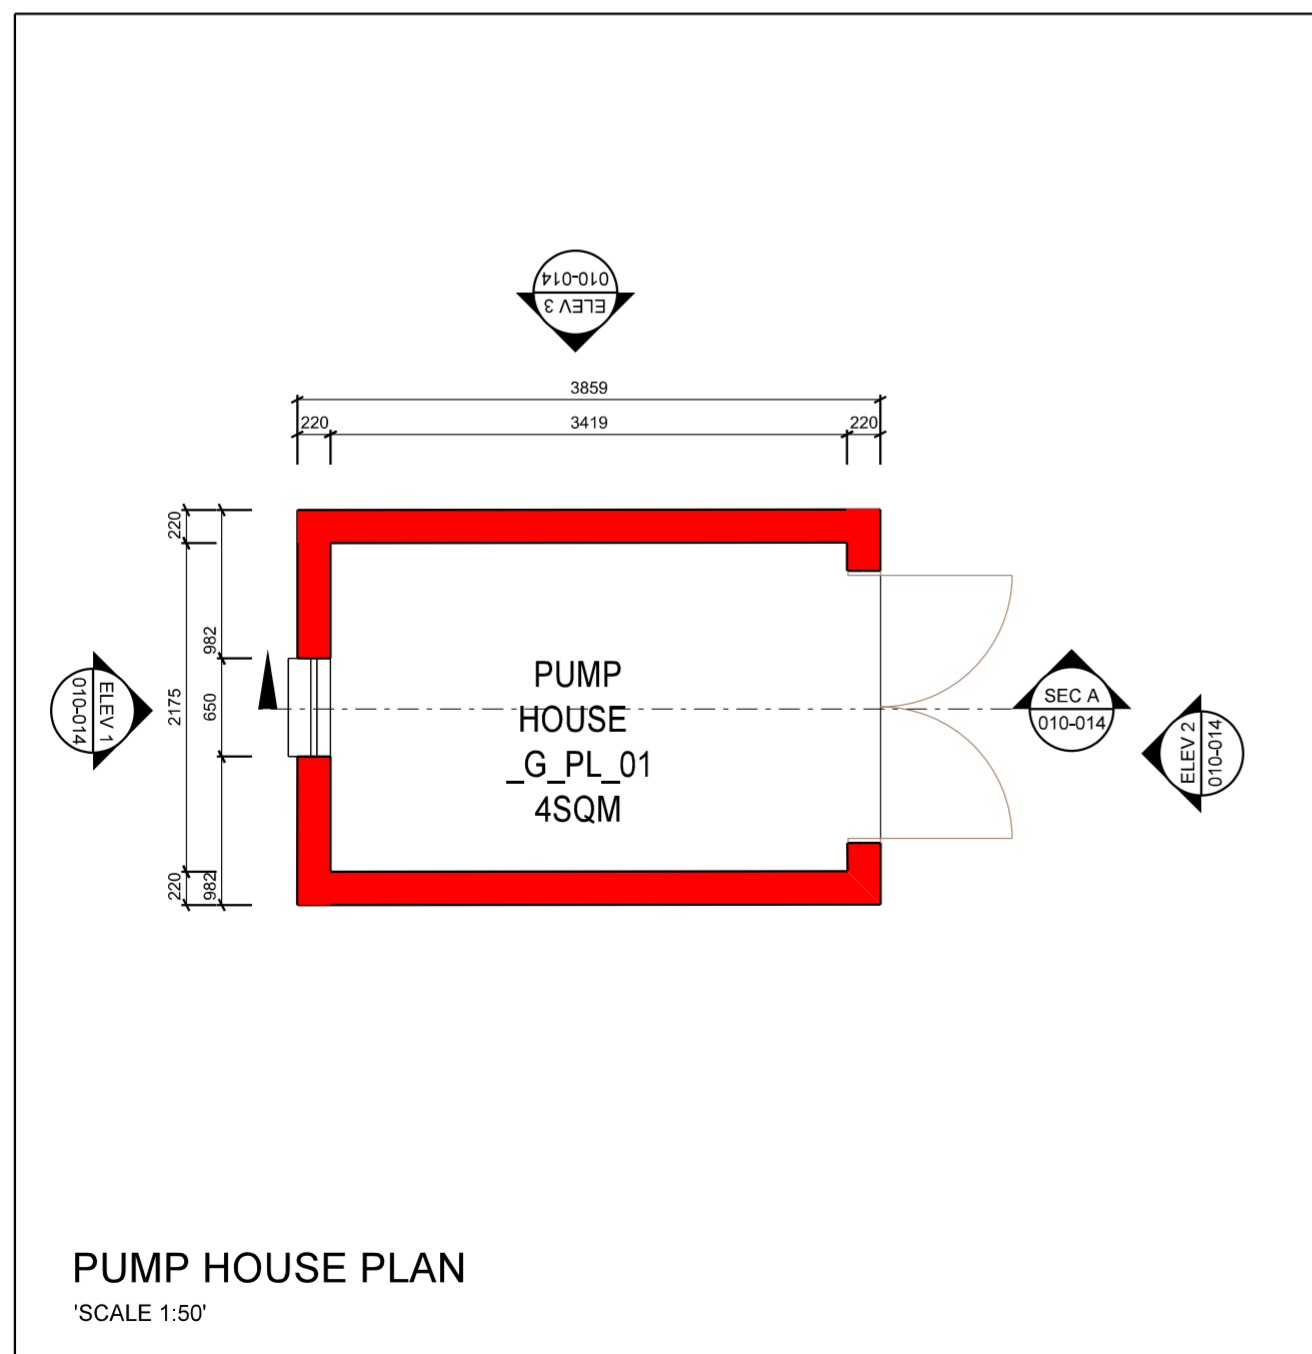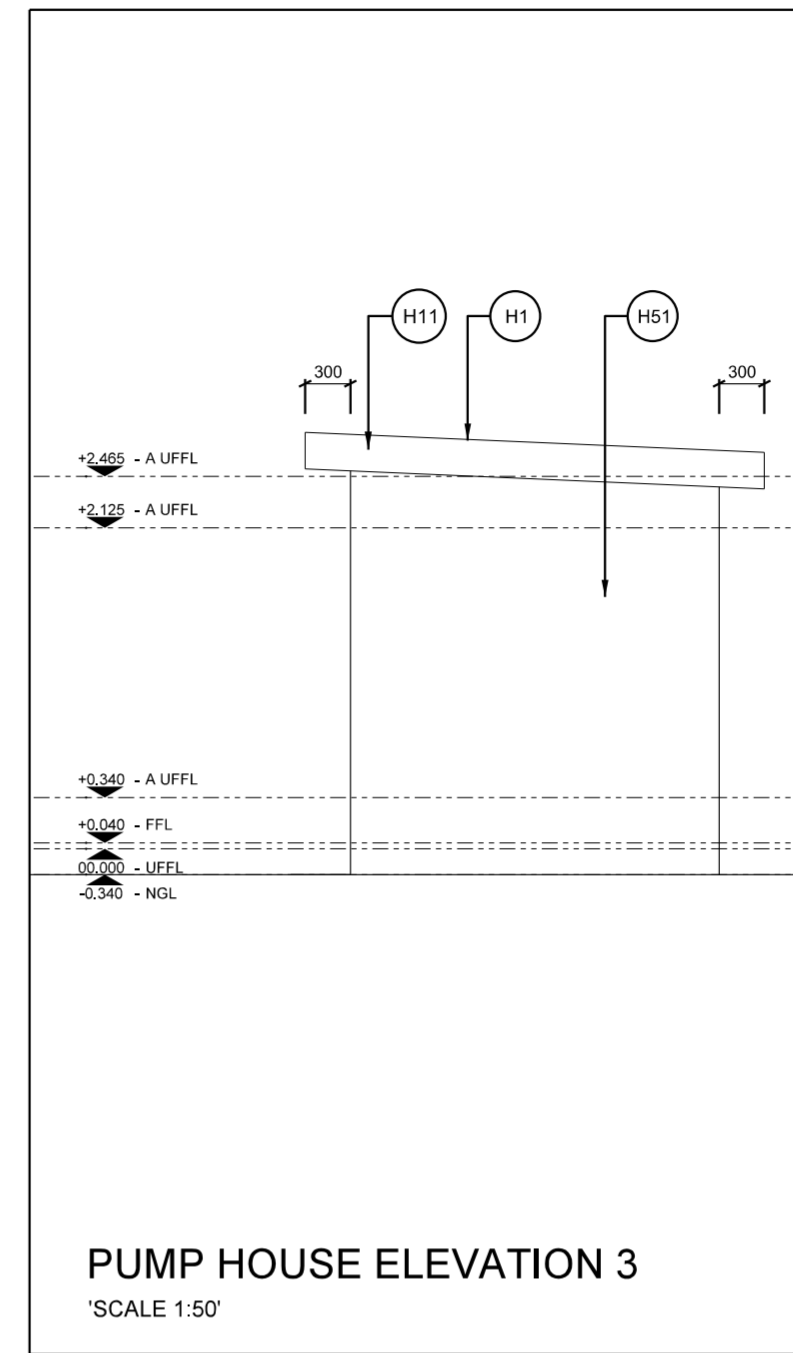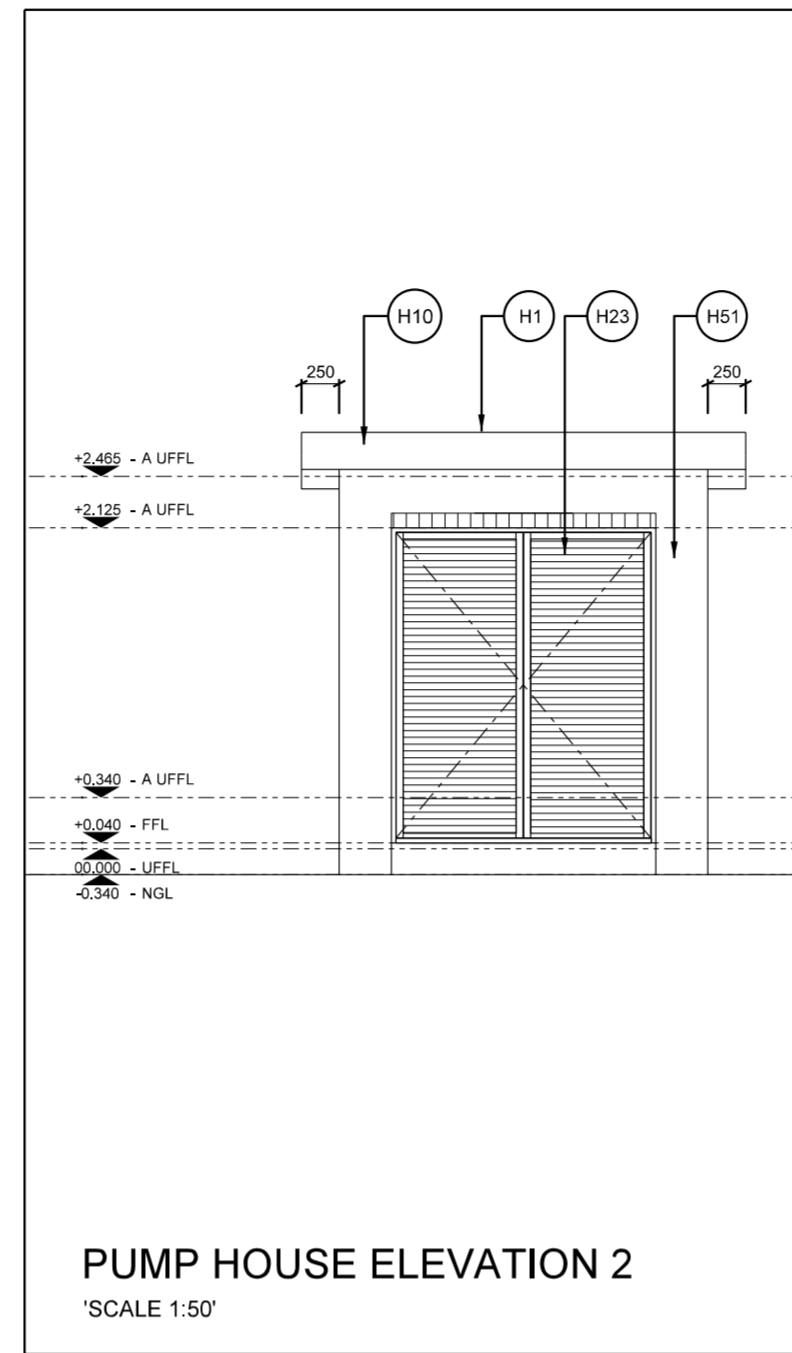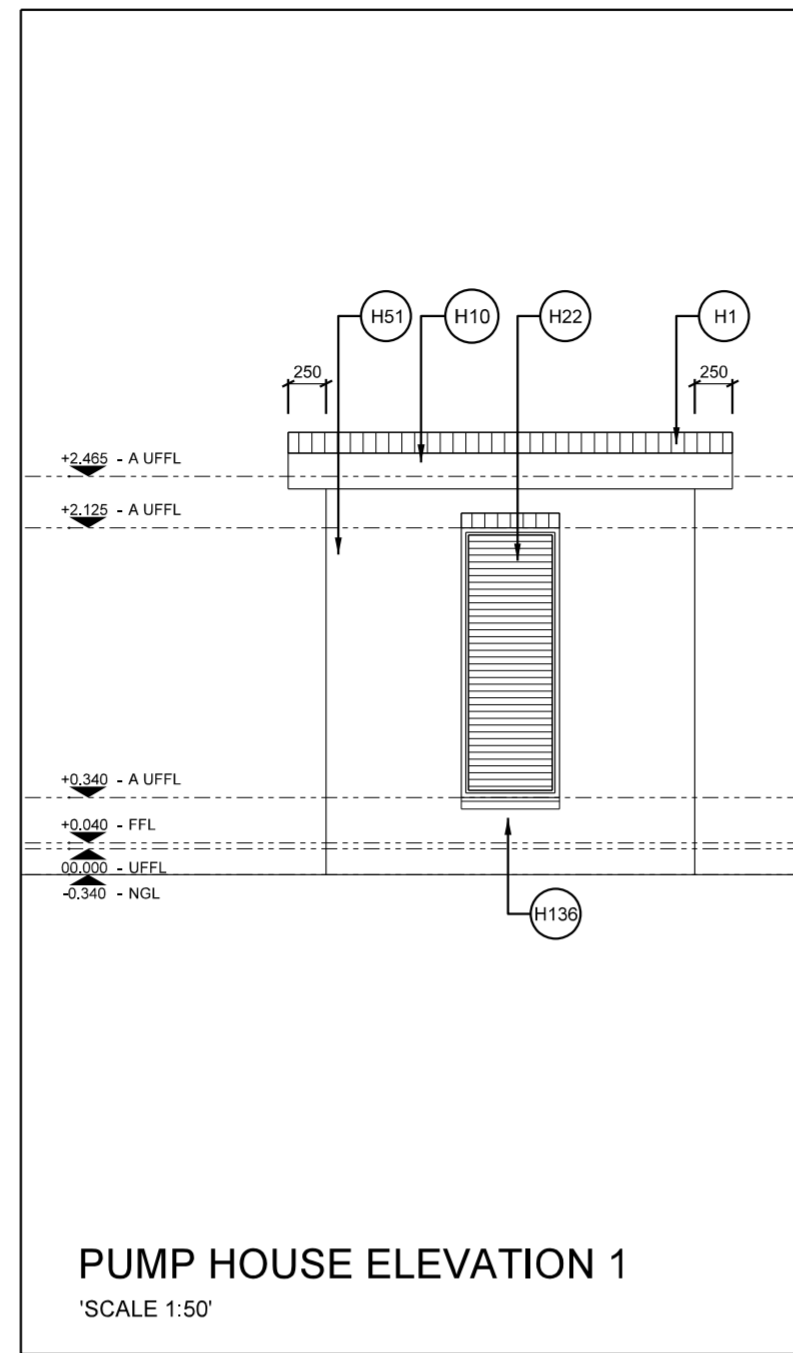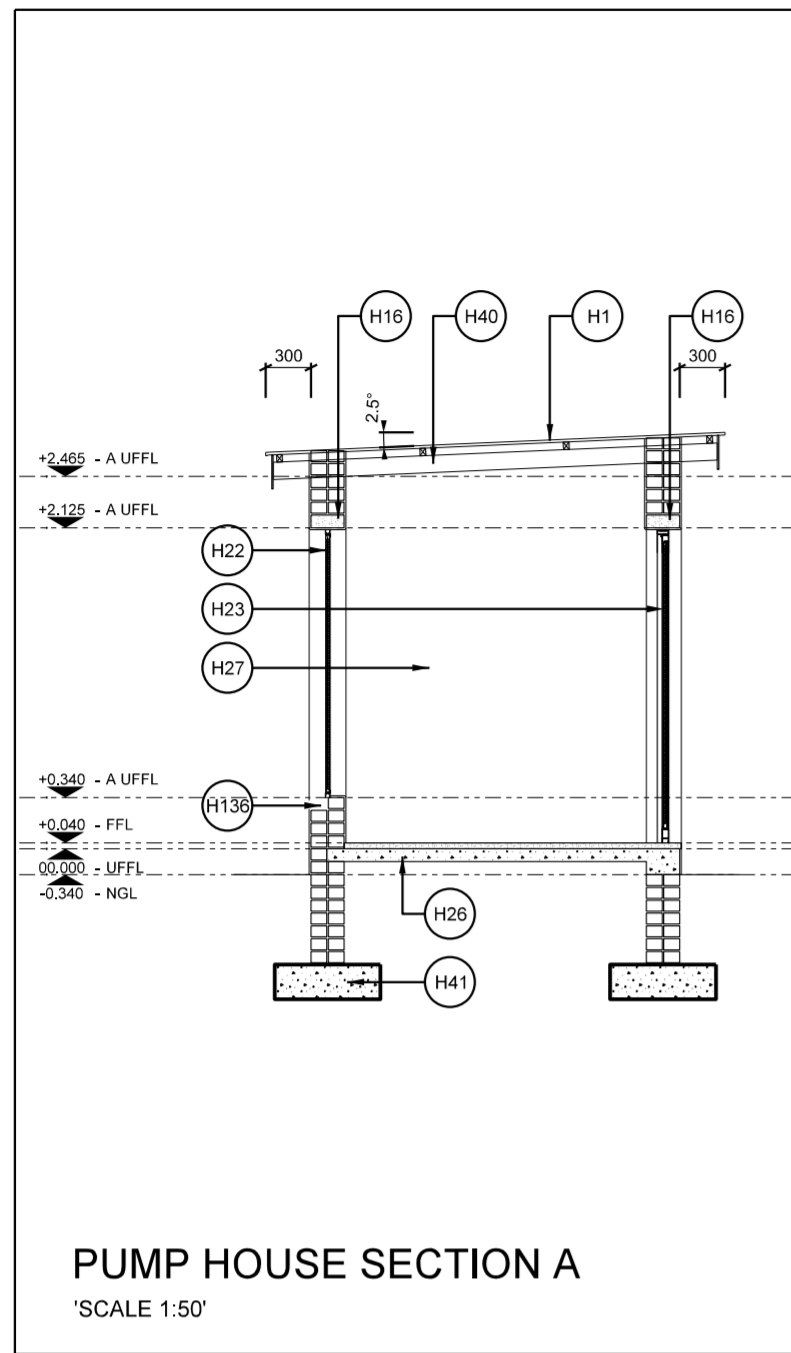

No.	DATE	AMENDMENT	D.P.W.

Copyright vests in the Department of Public Works

as-built drawings


certified as-built drawings as per Centralised Drawing Archive AS-BUILT DRAWING REQUIREMENTS

name: _____

date: _____

professional registration no.: _____

cad file name: 25500-010-014 page type: A 2

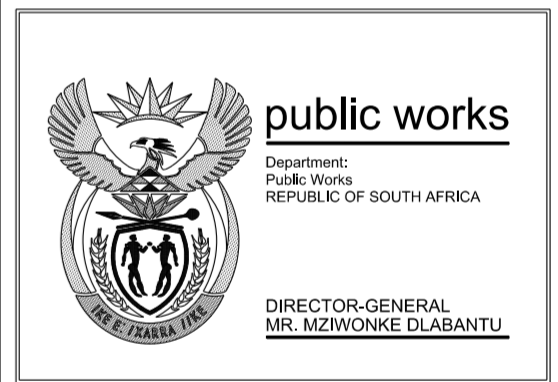

consultant: Bartsch
BARTSCH CONSULT (Pty) Ltd
REG. NO. CK 903189523

HARRISMITH: TEL(058) 6223471, P.O.BOX 762, HARRISMITH 9880
QUEENSTOWN: TEL(045) 839 5728, LADYSMITH: TEL(036) 631 1888
EAST LONDON: TEL(043) 727 0765, BLOEMFONTEIN: TEL (051) 300547
CAPE TOWN: TEL(021) 252225, PRETORIA: TEL(012) 3469526
WINDHOEK : TEL(0926461) 237403.

discipline: ARCHITECT

service: SKETCH PLANS


BERGVILLE JUSTICE - COMPLETE UPGRADING INCLUDING R & R

WCS number: WCS 036745

drawing title: PUMP HOUSE PLAN, ROOF PLAN, SECTION & ELEVATIONS

ref.no. _____ designed _____
scale 1:50 drawn CVDW
date 24-Nov-20 checked _____

DPW drawing number: 25500-010-014 R00
13-Jan-14

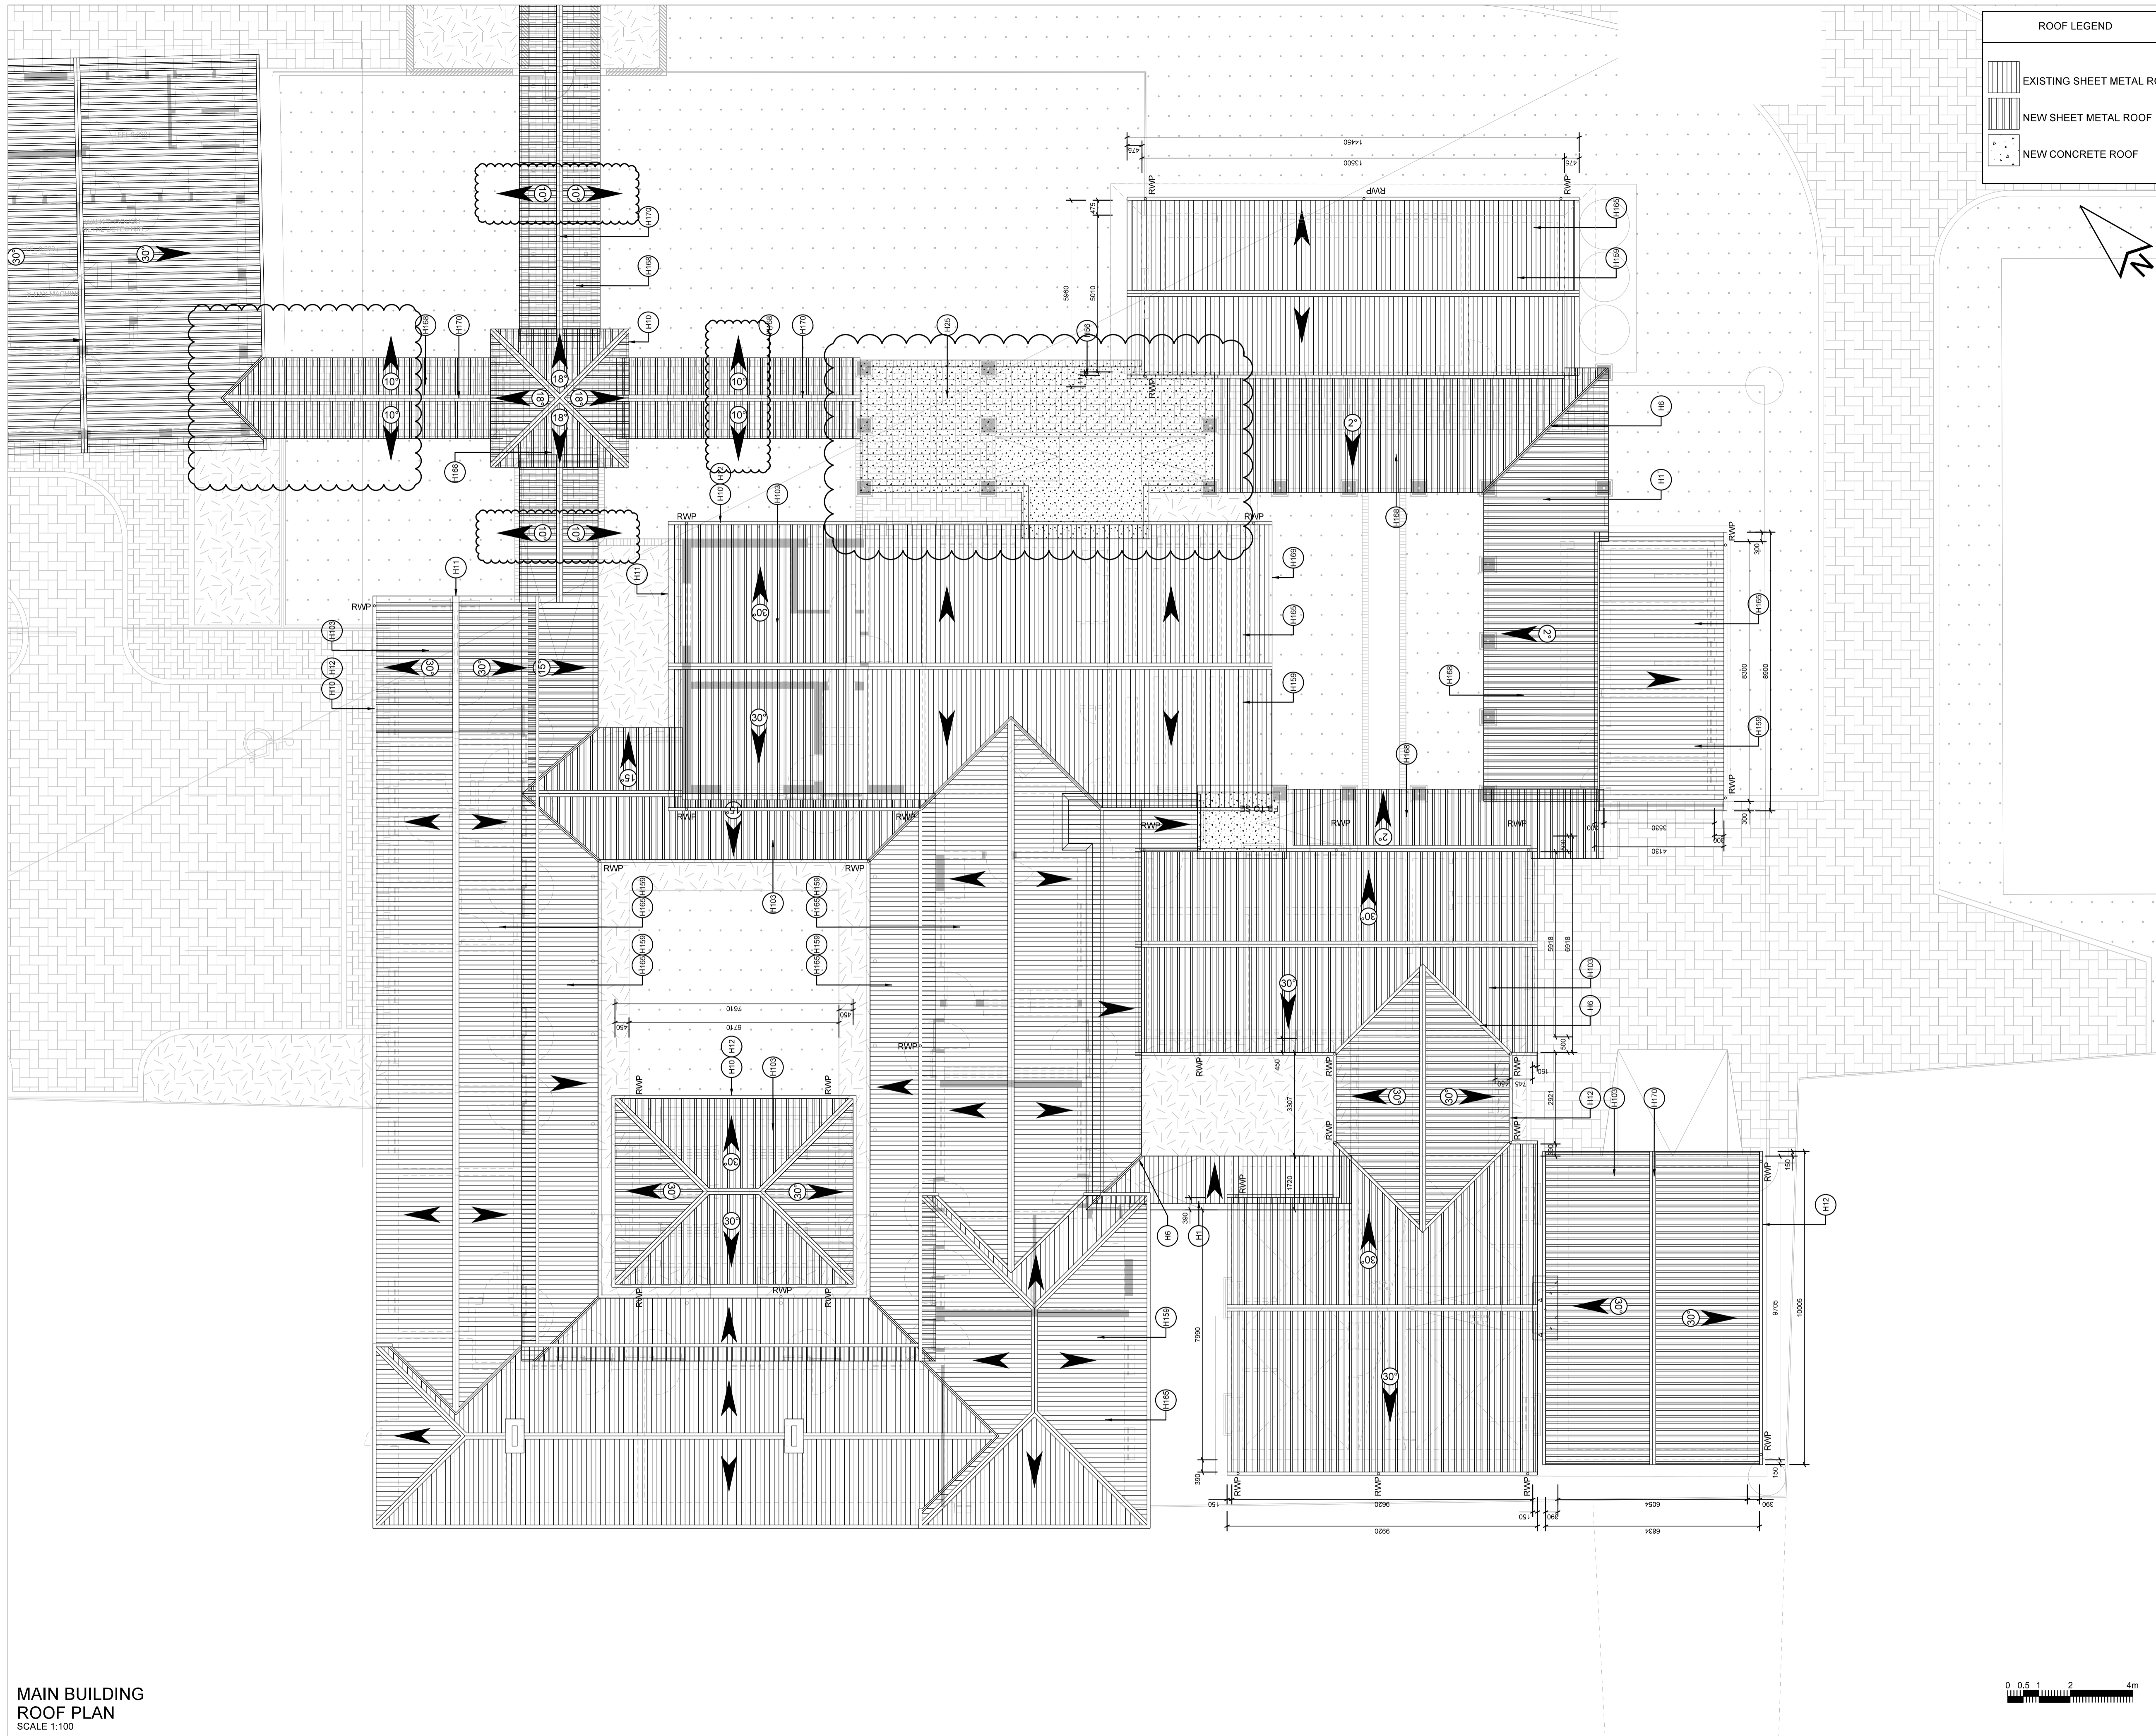

ROOF LEGEND		
	EXISTING SHEET METAL ROOF	
	NEW SHEET METAL ROOF	
	NEW CONCRETE ROOF	

No.	DATE	AMENDMENT	D.P.W.
<small>R01/ 2013/03/01/ FJP/ AD DETAIL REFERENCES. R02/ 2013/12/04/ MFT/ Entrance canopy roof updated. R03/ 2020/12/09/ BVS/ Revised to include new boardroom / library R04/ 2021-04-16/ BVS/ Revised according to changes on plan R05/ 2021-04-21/ BVS/ Concrete slab revised to accommodate existing roof and fullcore added. New H-motes added. R05/ 2021-04-21/ BVS/ Main entrance roof slab revised to include upstands. Walkway roof revised</small>			

Copyright vests in the
Department of Public Works

as-built drawings


certified as-built drawings as per Centralised Drawing
Archive AS-BUILT DRAWING REQUIREMENTS

name: _____

date: _____

professional registration no.: _____

cad file name: 25500-014-001 page type: A 1

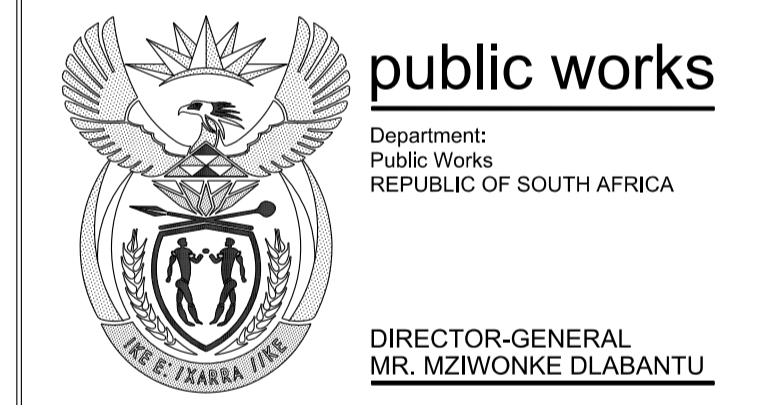

consultant
COPYRIGHT

Bartsch
BARTSCH CONSULT (Pty) Ltd
REG. NO. CK 903189523

HARRISMITH: TEL(051) 5223471, P.O.BOX 762, HARRISMITH 9690
QUEENSTOWN: TEL(045) 839 5728, LADYSMITH: TEL(036) 631 1888
EAST LONDON: TEL(043) 727 0765, BLOEMFONTEIN: TEL (051) 300547
CAPE TOWN: TEL(021) 252225, PRETORIA: TEL(012) 3465526
WINDHOEK : TEL(0926461) 237403.

discipline: ARCHITECT

service:

SKETCH PLANS

BERGVILLE JUSTICE - COMPLETE
UPGRADING INCLUDING R & R

WCS number: WCS 036745

drawing title
"MAIN BUILDING - ROOF PLAN;
WAITING - ROOF PLAN;
ABLUTION - ROOF PLAN;
GATE HOUSE - ROOFPLAN"


ref.no. _____ designed _____


scale: 1:100 drawn: BVS

date: 21-Apr-21 checked _____


DPW drawing number: 25500-014-001 R05
21-Apr-21

MAIN BUILDING
ROOF PLAN
SCALE 1:100

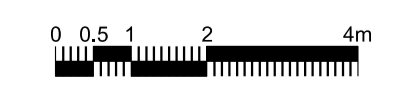


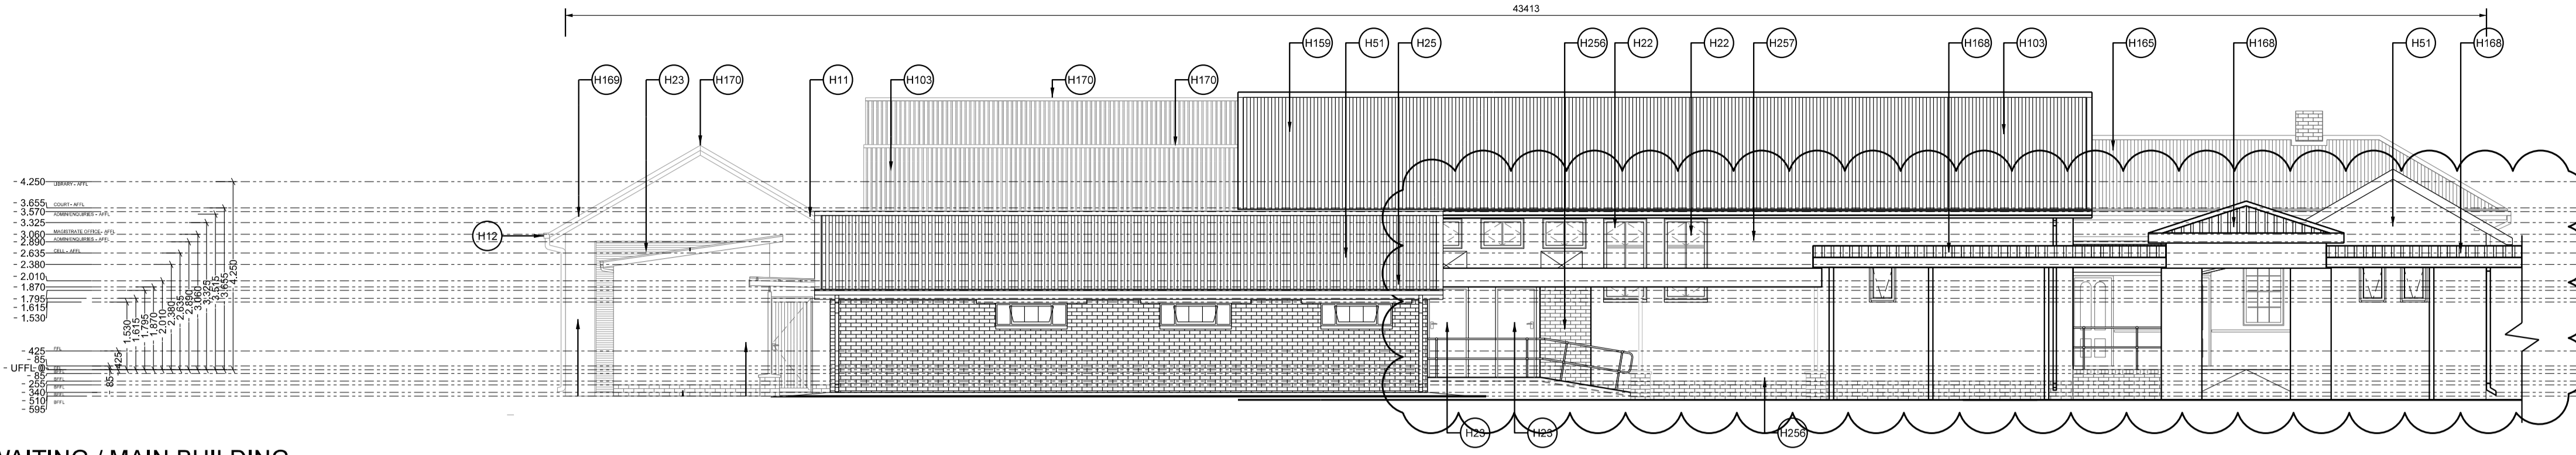


WAITING / MAIN BUILDING -
NORTH ELEVATION
SCALE 1:100

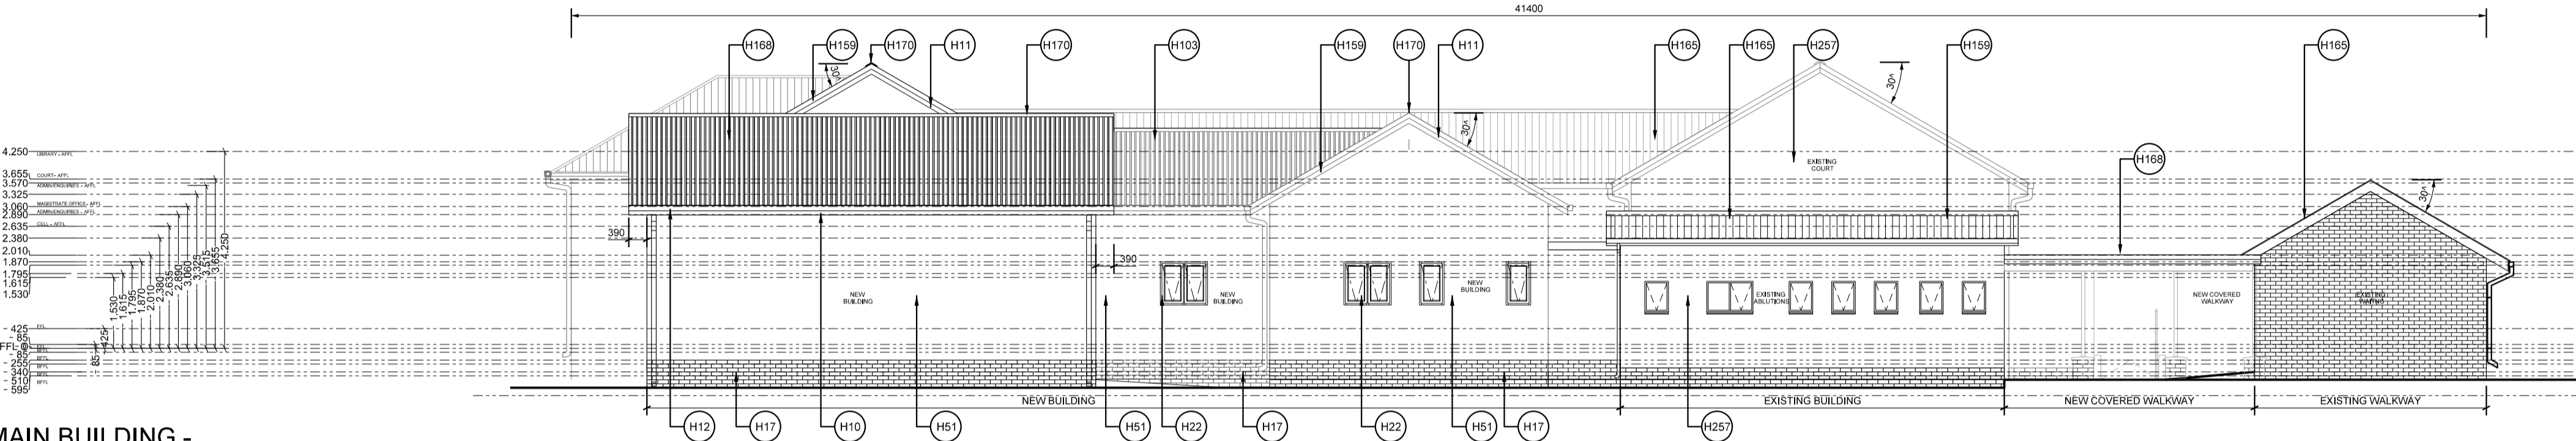

MAIN BUILDING -
EAST ELEVATION
SCALE 1:100

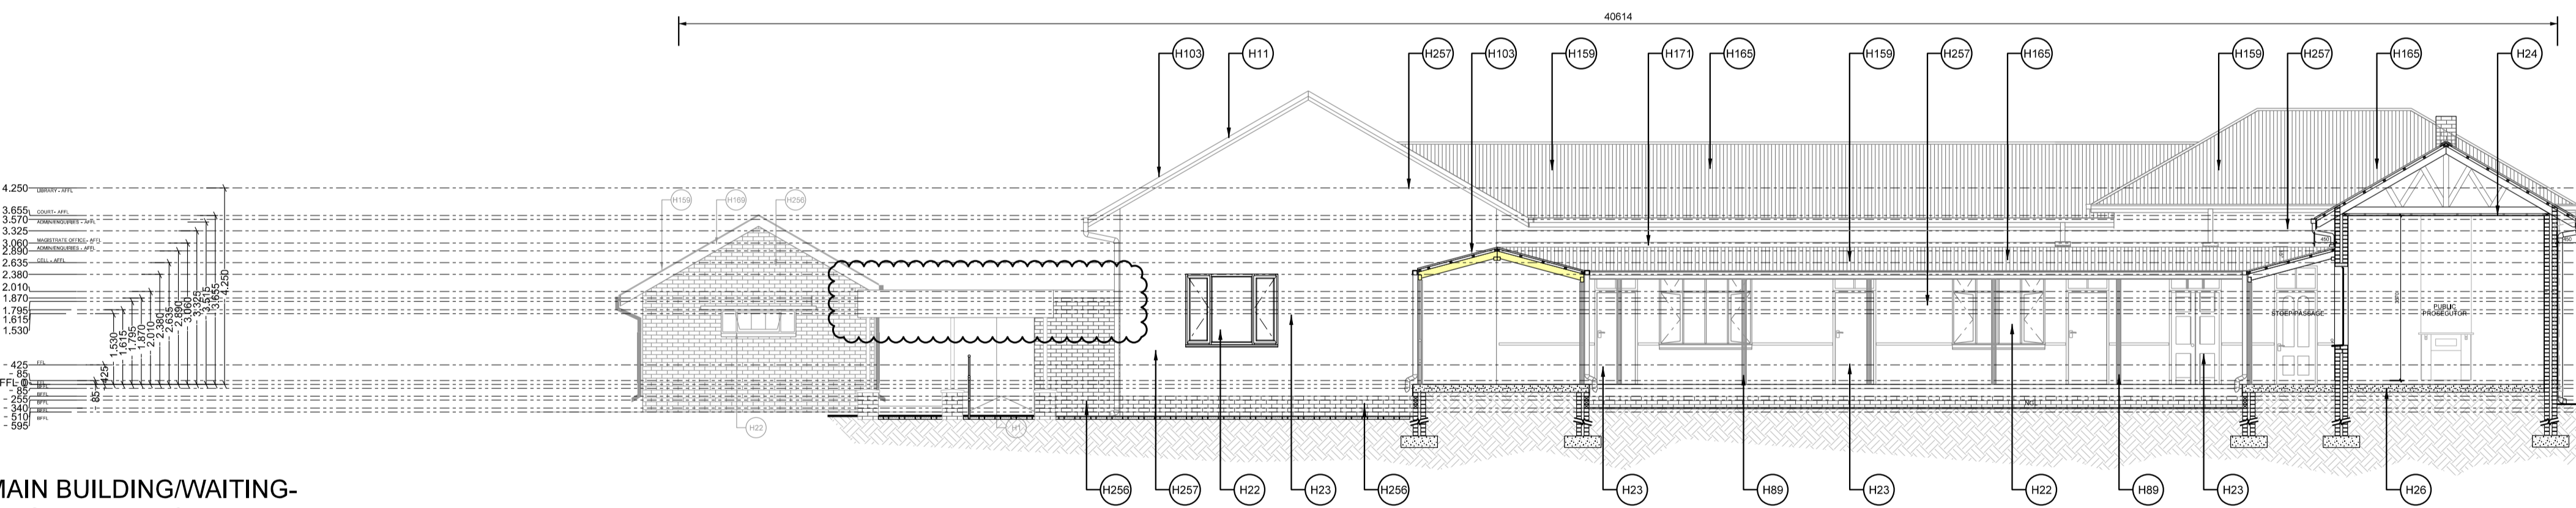

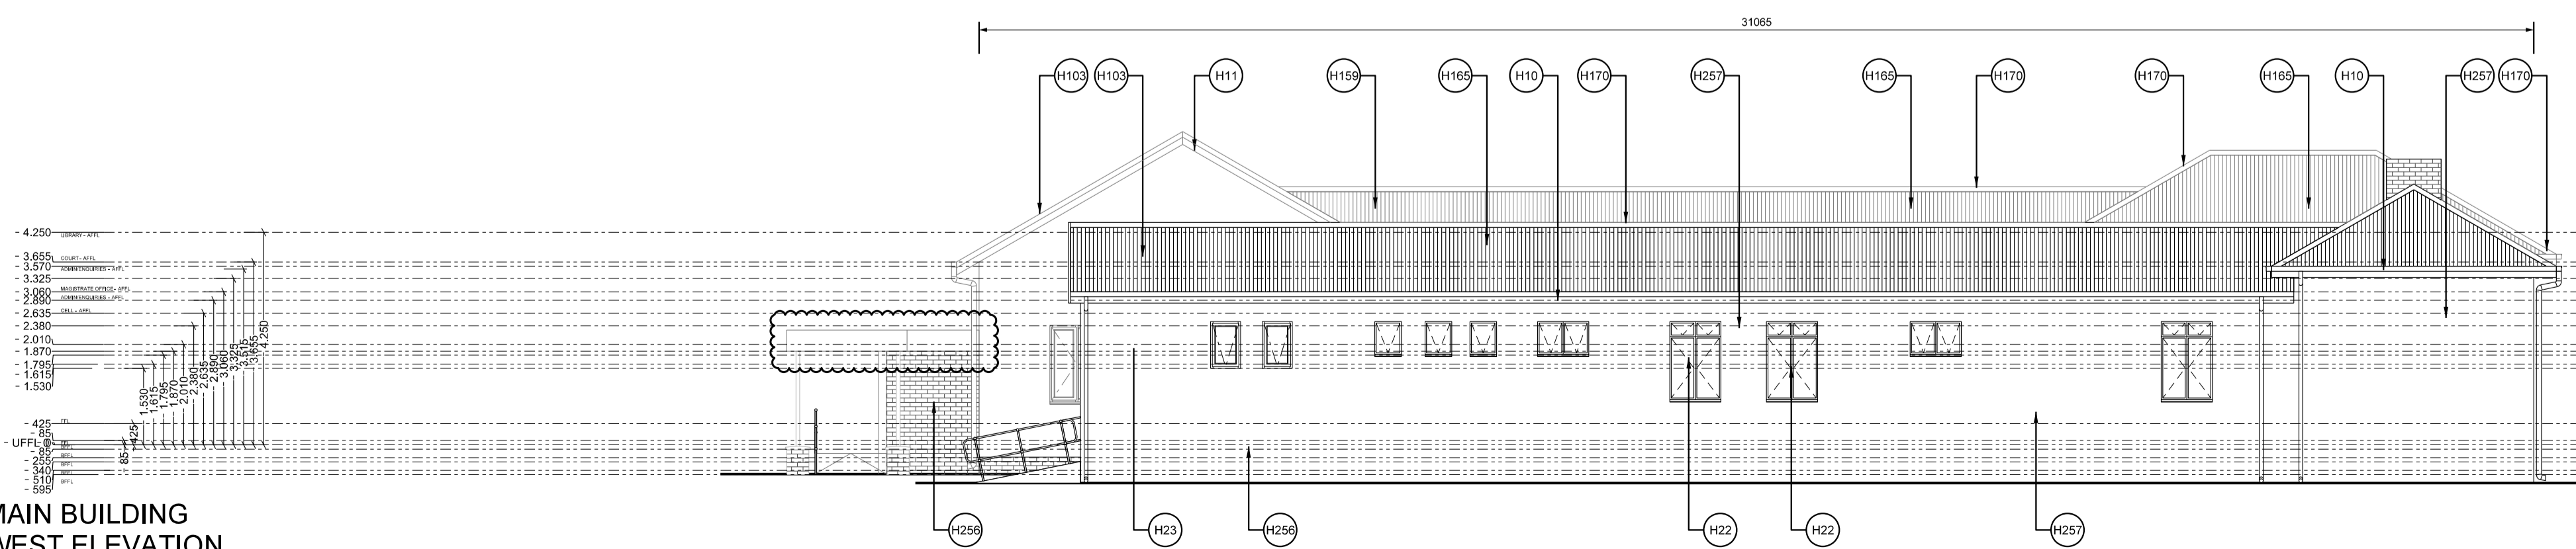








MAIN BUILDING/WAITING -
WEST ELEVATION
SCALE 1:100



MAIN BUILDING
WEST ELEVATION
SCALE 1:100



No.	DATE	AMENDMENT	D.P.W.
<small>R01/ 2013/03/01/ FJP/ REVISED ELEVATIONS ACCORDING TO CHANGES ON PLAN AND SECTIONS R02/ 2019/12/11/ BVS/ Dimensions added. R03/ 2021-04-09/ BVS/ Revised according to changes on plan and roof plan. R04/ 2021-04-16/ BVS/ Revised H-notes R04/ 2021-04-21/ BVS/ Revised according to changes on roof plan and sections</small>			
Copyright vests in the Department of Public Works			
as-built drawings			
certified as-built drawings as per Centralised Drawing Archive AS-BUILT DRAWING REQUIREMENTS			
name: _____			
date: _____			
professional registration no.: _____			
cad file name		page type	
25500-030-001		A 1	
 public works Department: Public Works REPUBLIC OF SOUTH AFRICA DIRECTOR-GENERAL MR. MZIWONKE DLABANTU			
consultant			
 Bartsch BARTSCH CONSULT (Pty) Ltd REG. NO. CK 903189523 HARRISMITH: TEL(051) 5223471, P.O.BOX 762, HARRISMITH 9690 QUEENSTOWN: TEL(045) 839 5728, LADYSMITH: TEL(036) 631 1888 EAST LONDON: TEL(043) 727 0765, BLOEMFONTEIN: TEL (051) 300547 CAPE TOWN: TEL(021) 252225, PRETORIA: TEL(012) 3465526 WINDHOEK : TEL(0926461) 237403.			
discipline			
ARCHITECT			
service			
SKETCH PLANS			
BERGVILLE JUSTICE - COMPLETE UPGRADING INCLUDING R & R			
WCS number		WCS 036745	
drawing title			
"MAIN BUILDING - ELEVATIONS; WAITING - ELEVATIONS;"			
ref.no.		designed	
scale 1:100		drawn BVS	
date 21-Apr-21		checked	
DPW drawing number			
25500-030-001		R04 21-Apr-21	

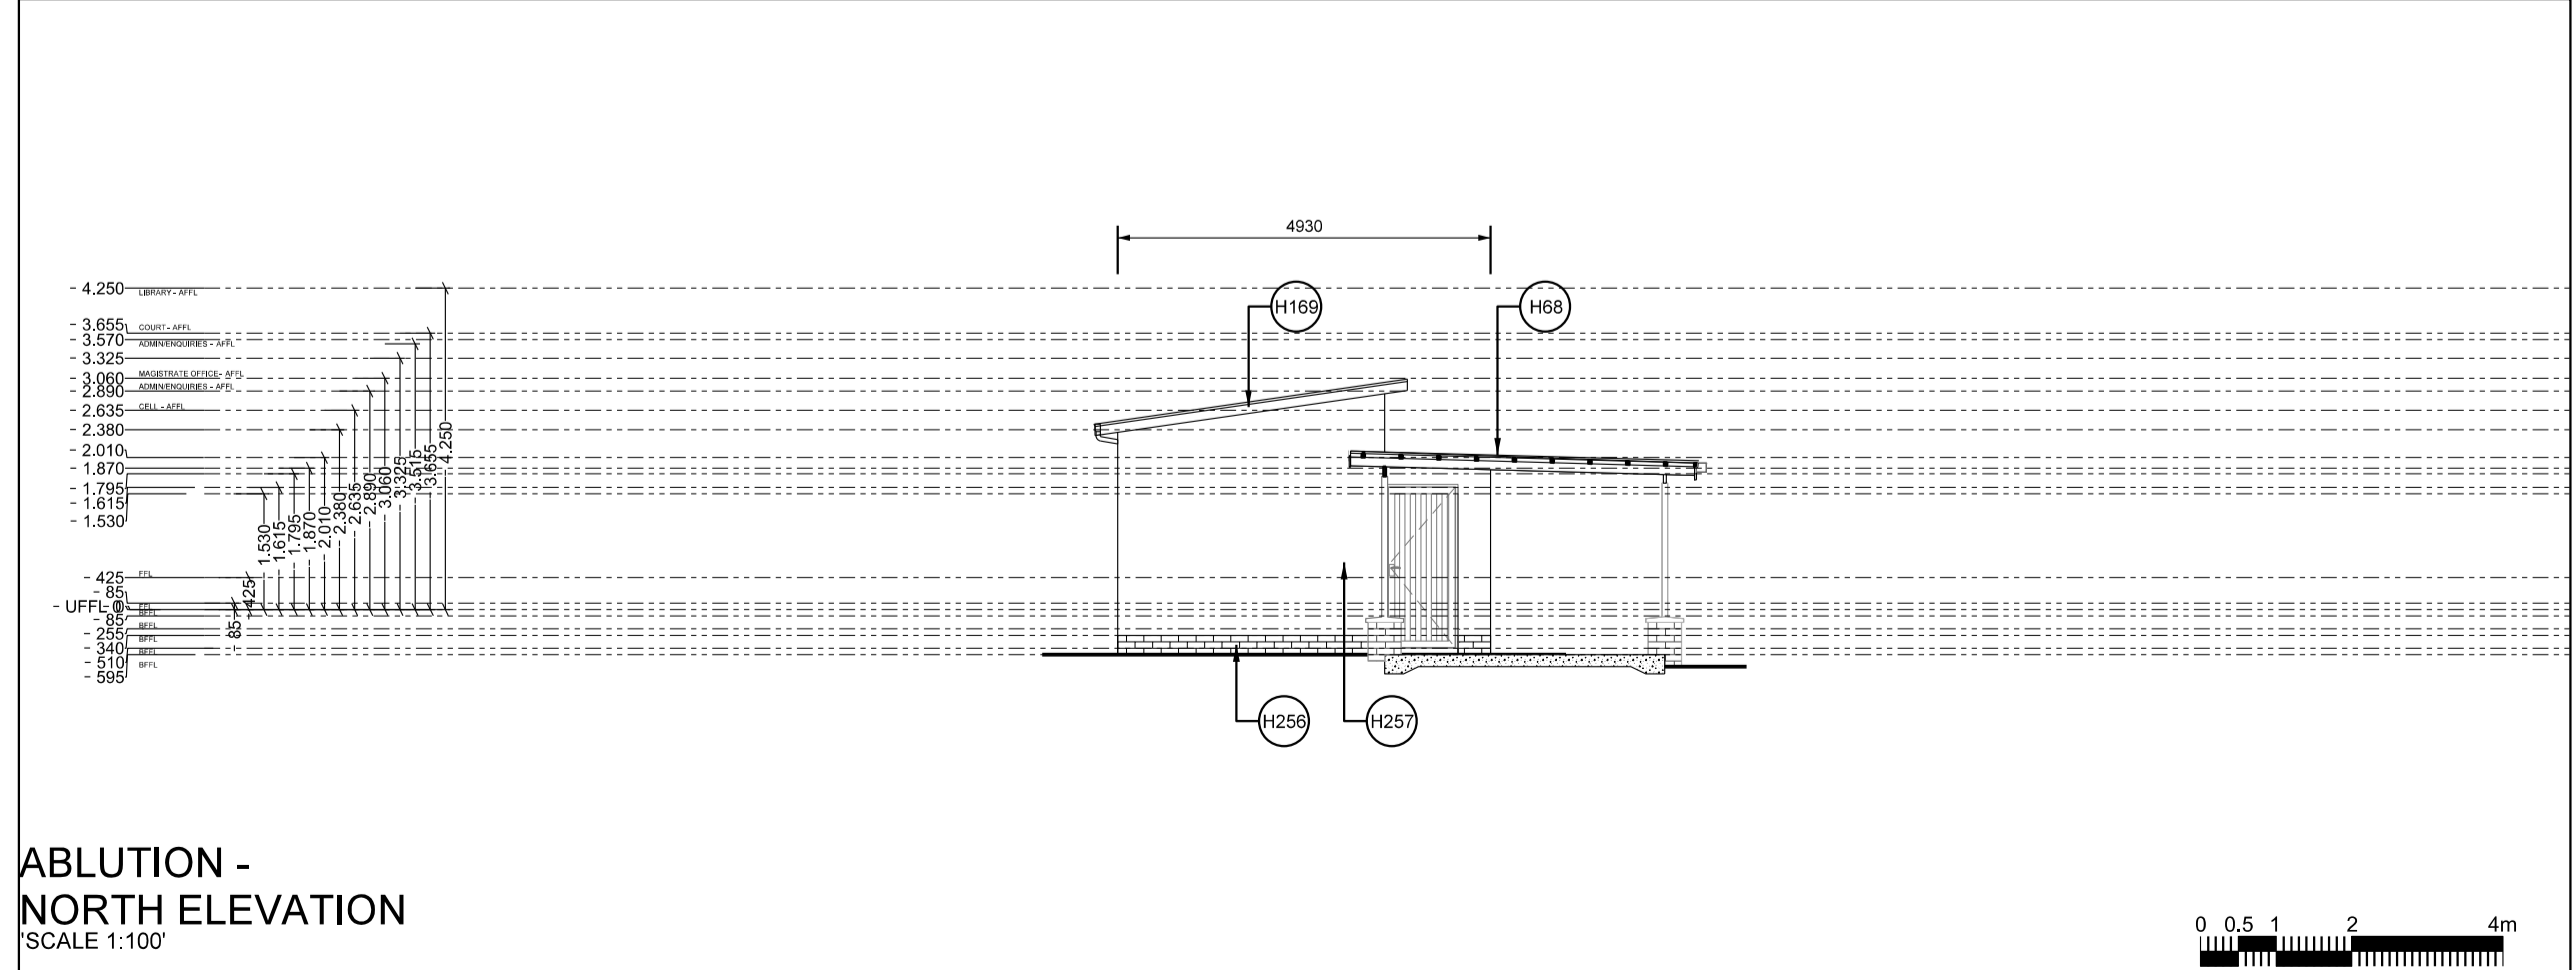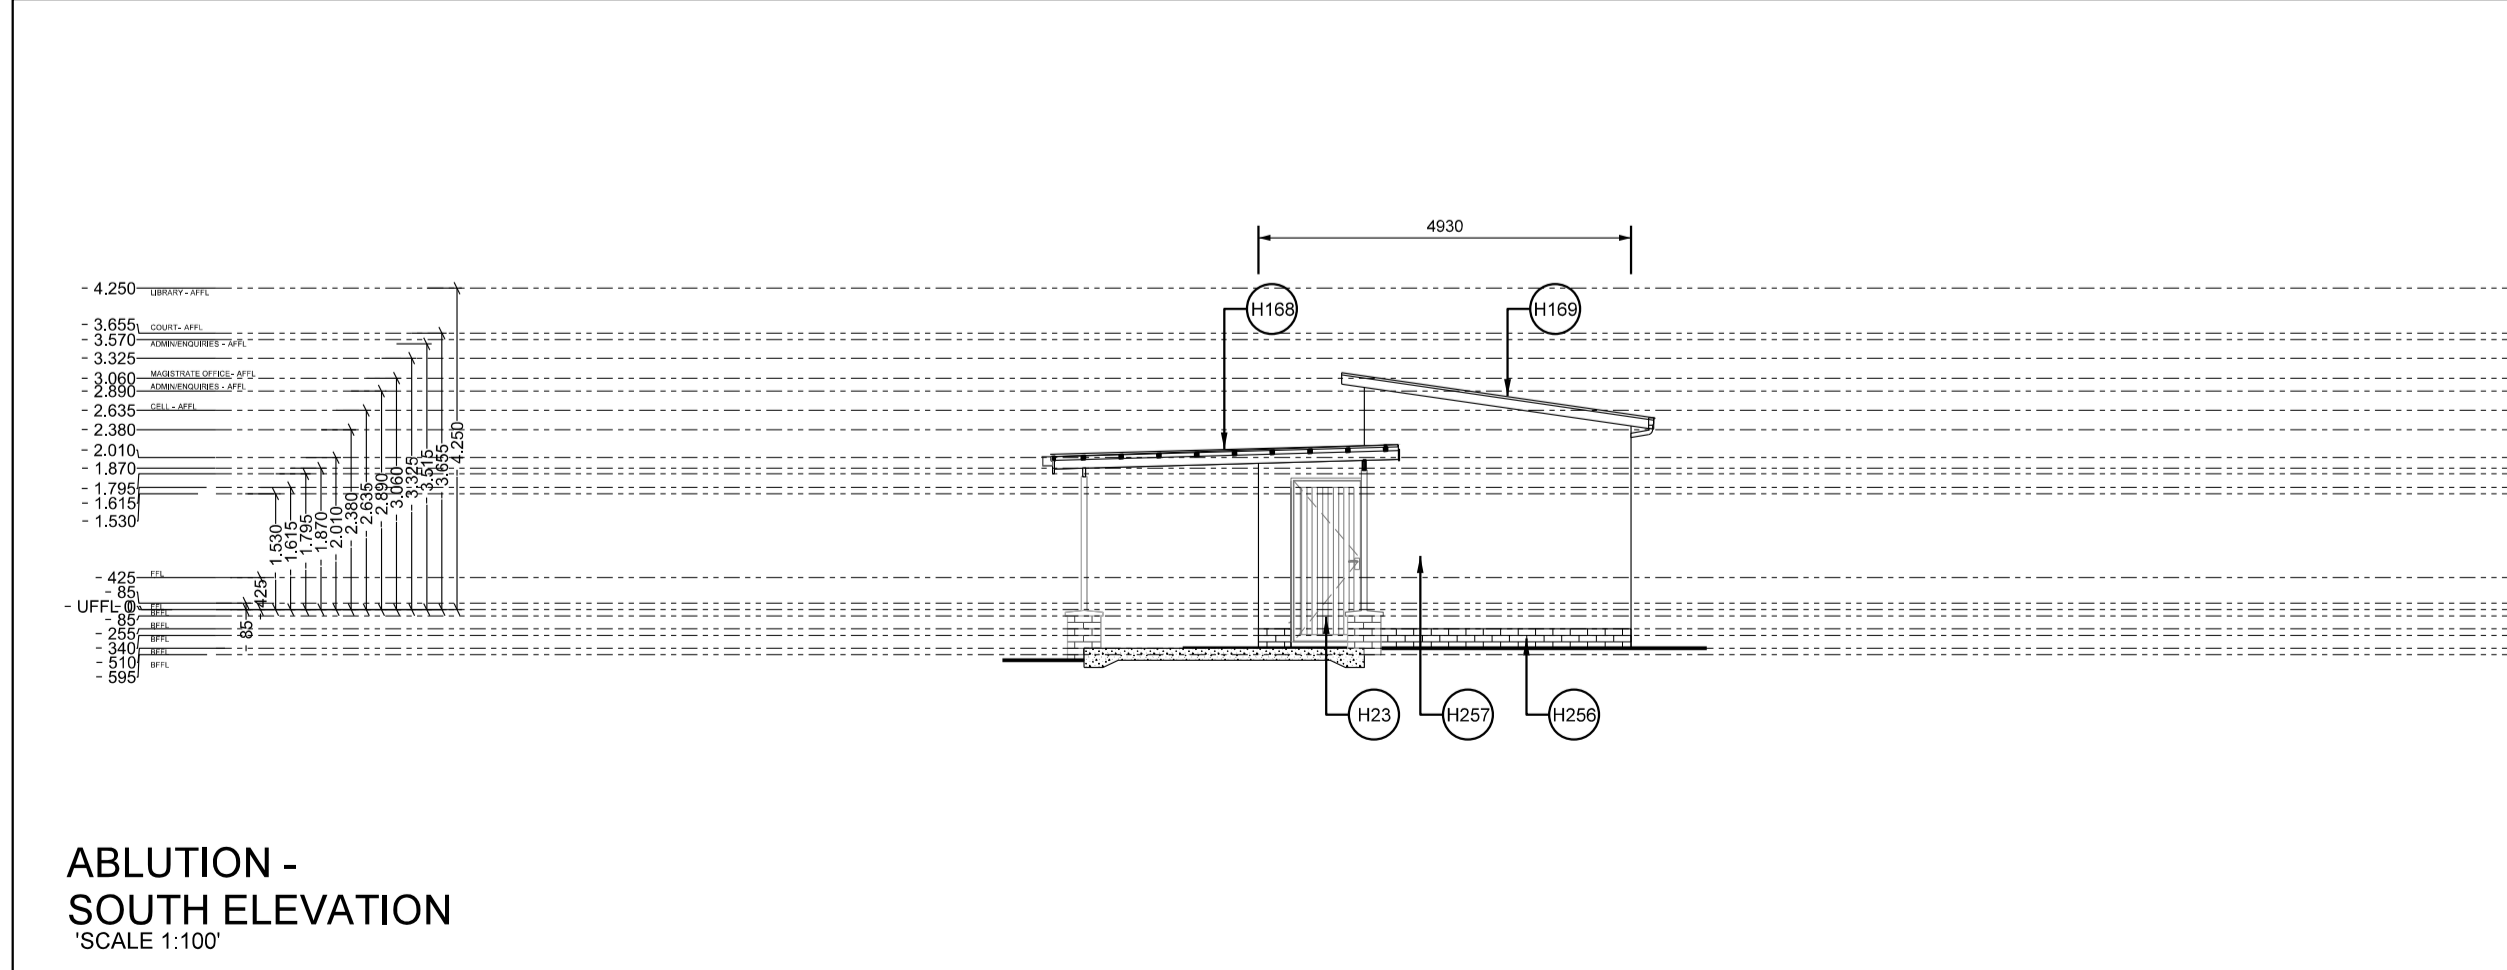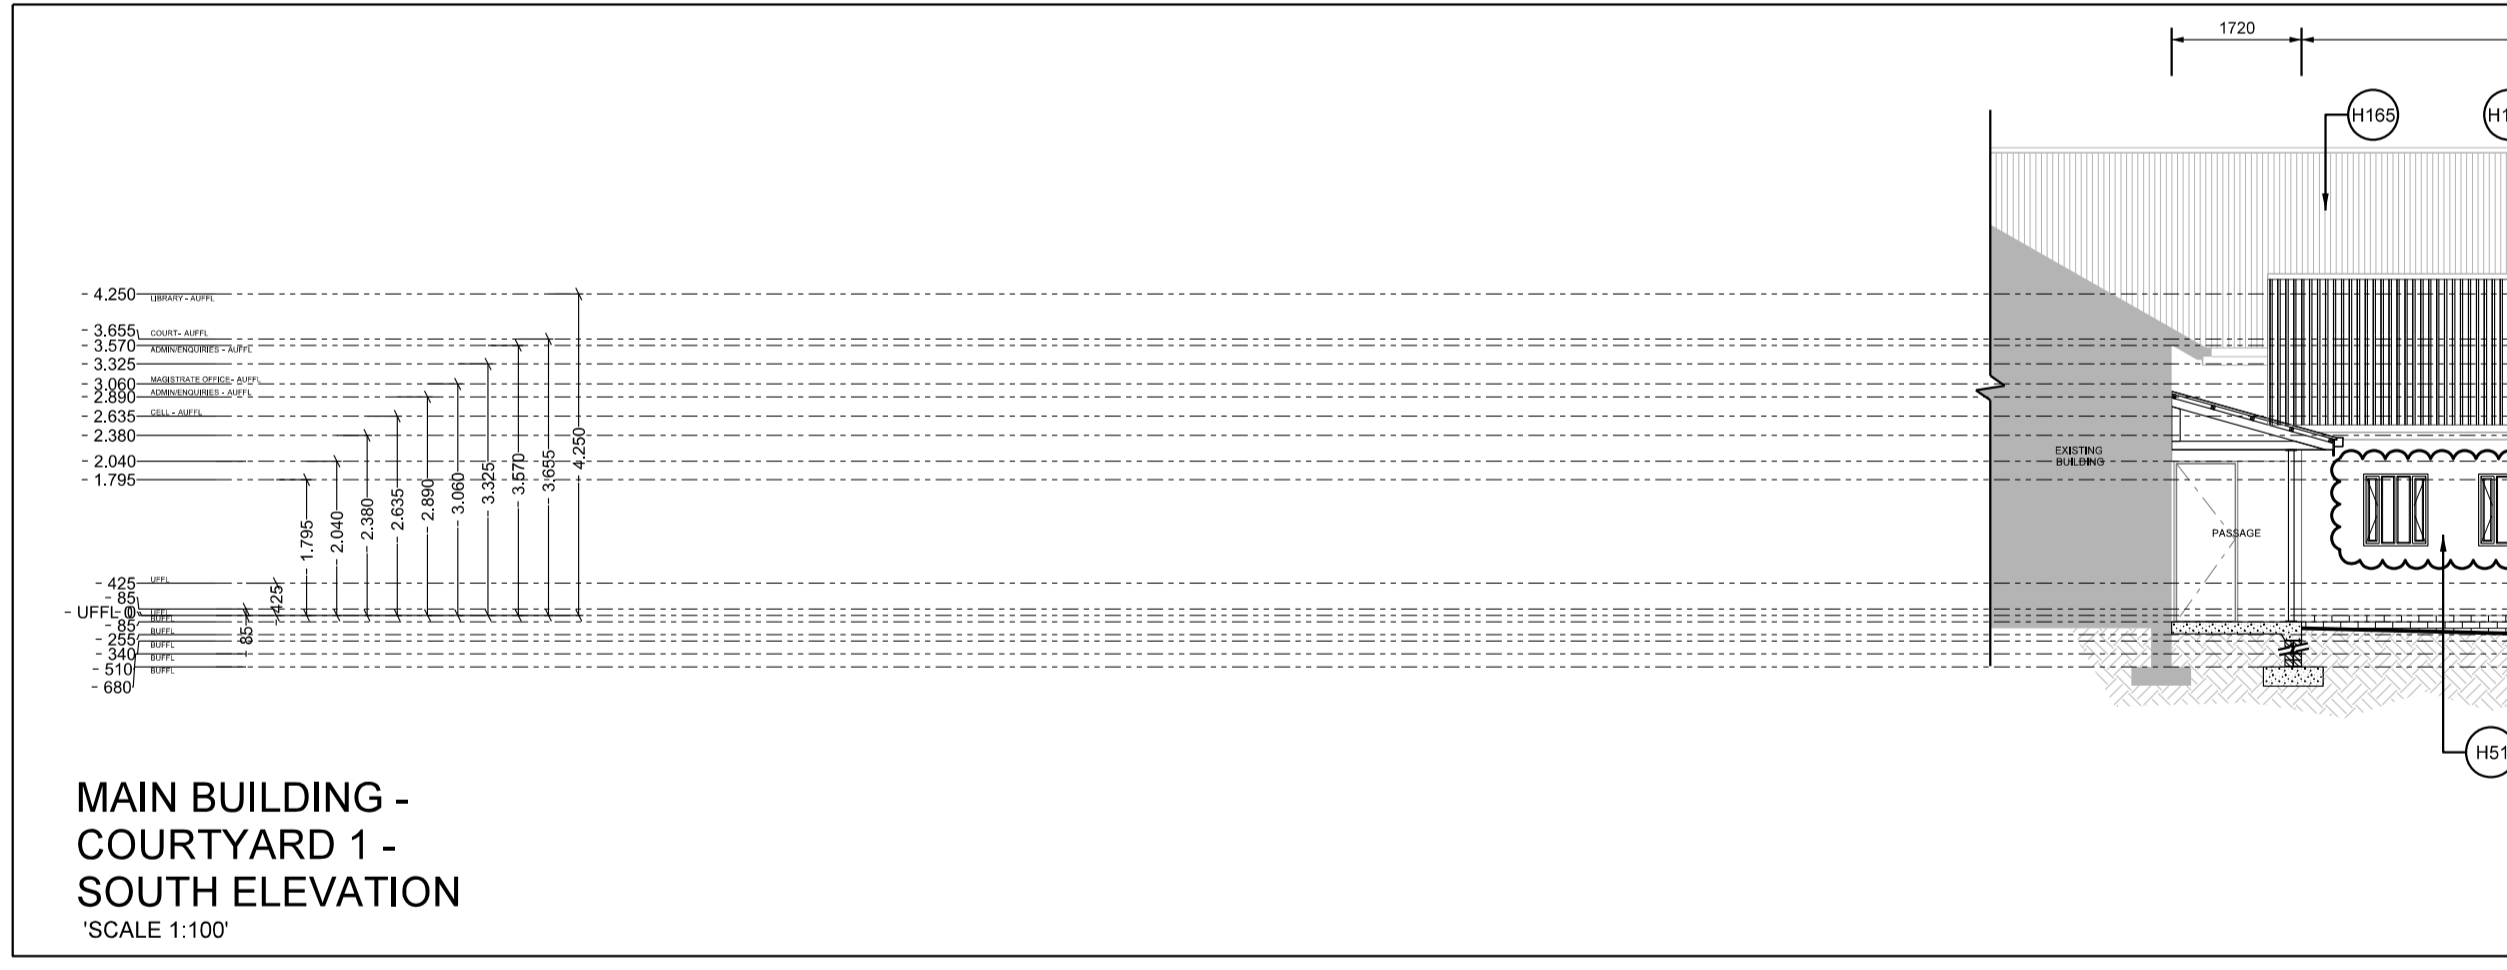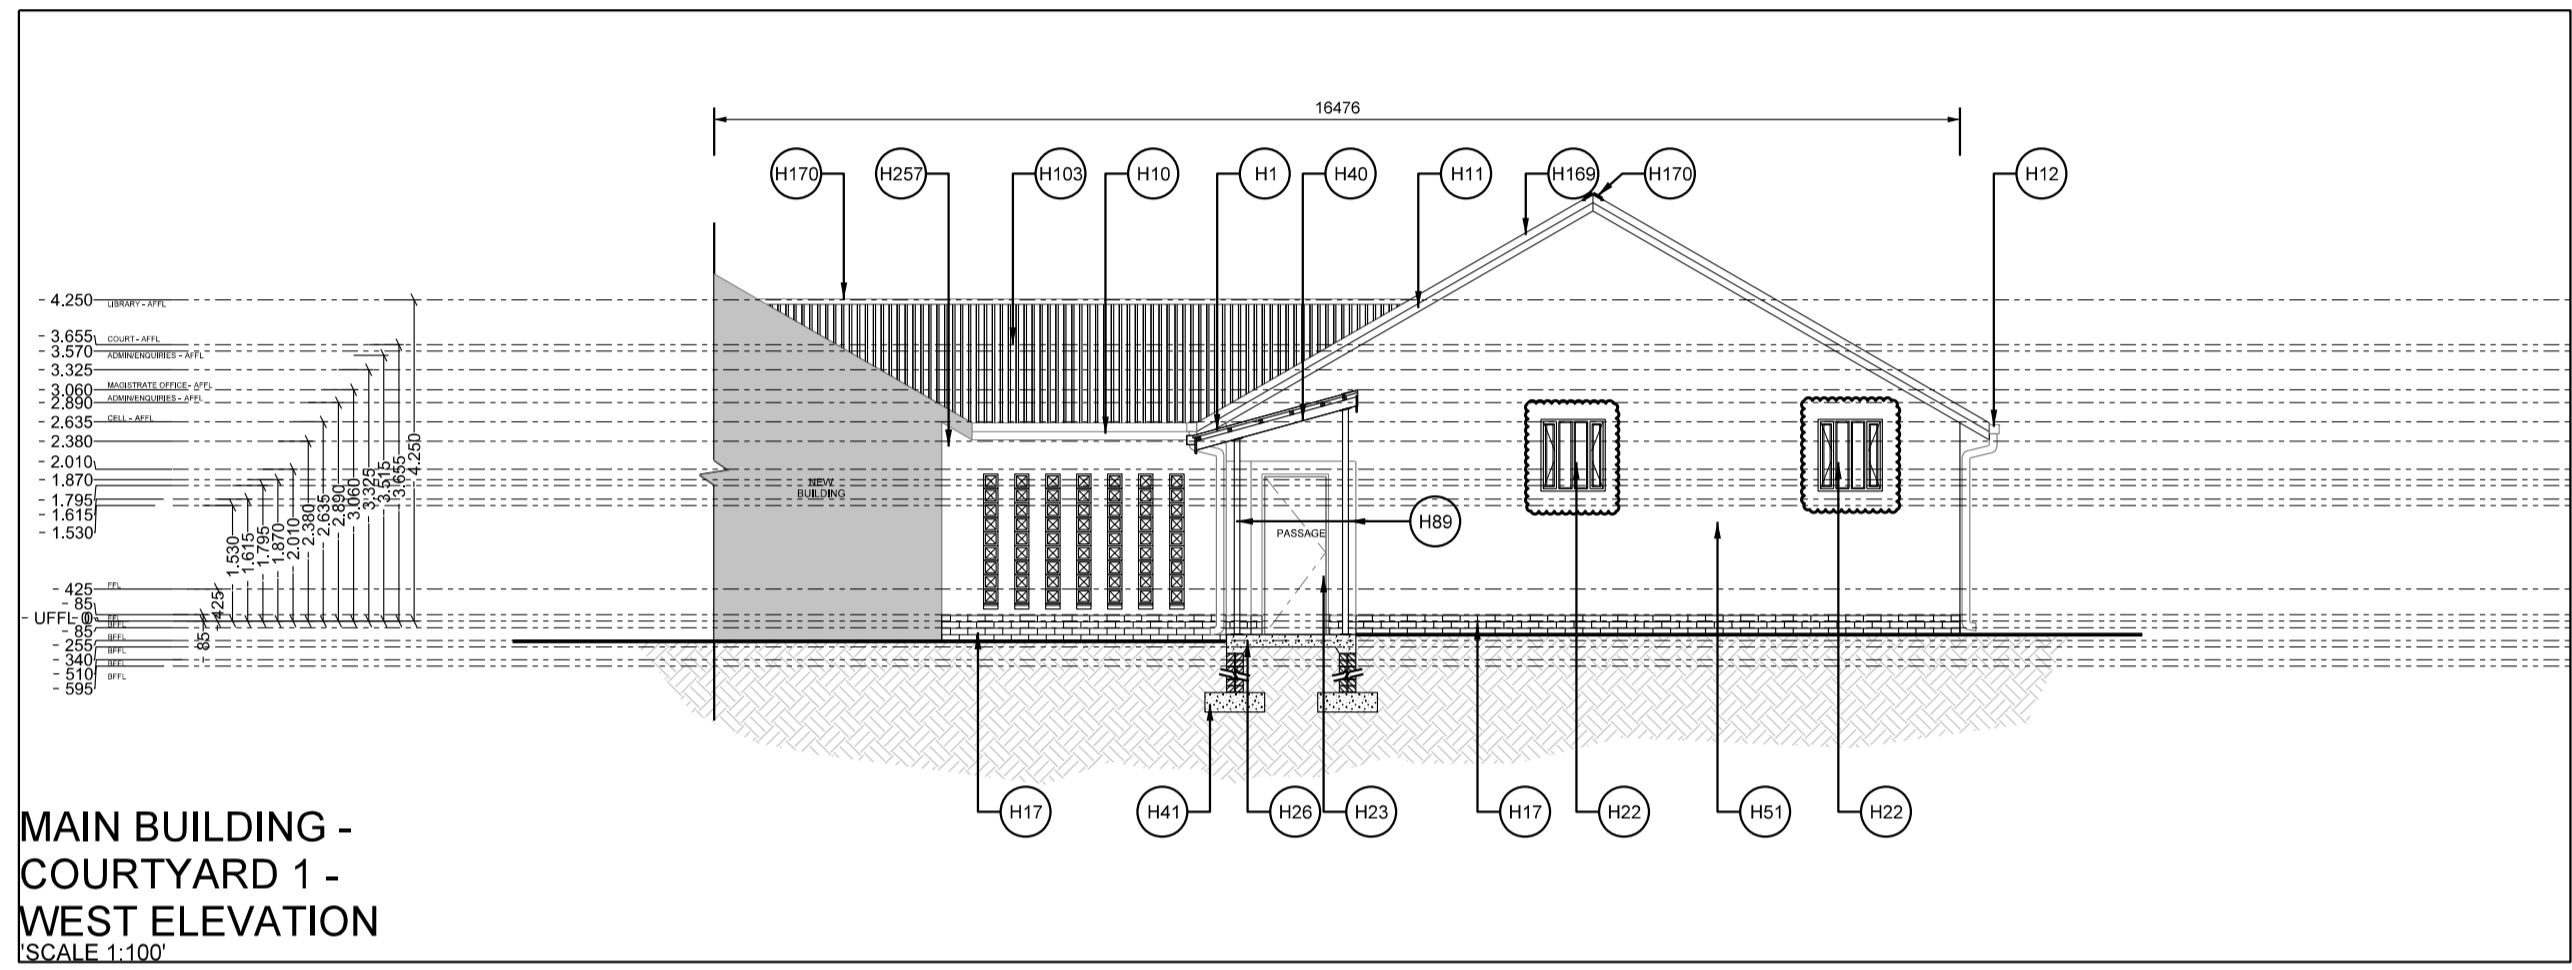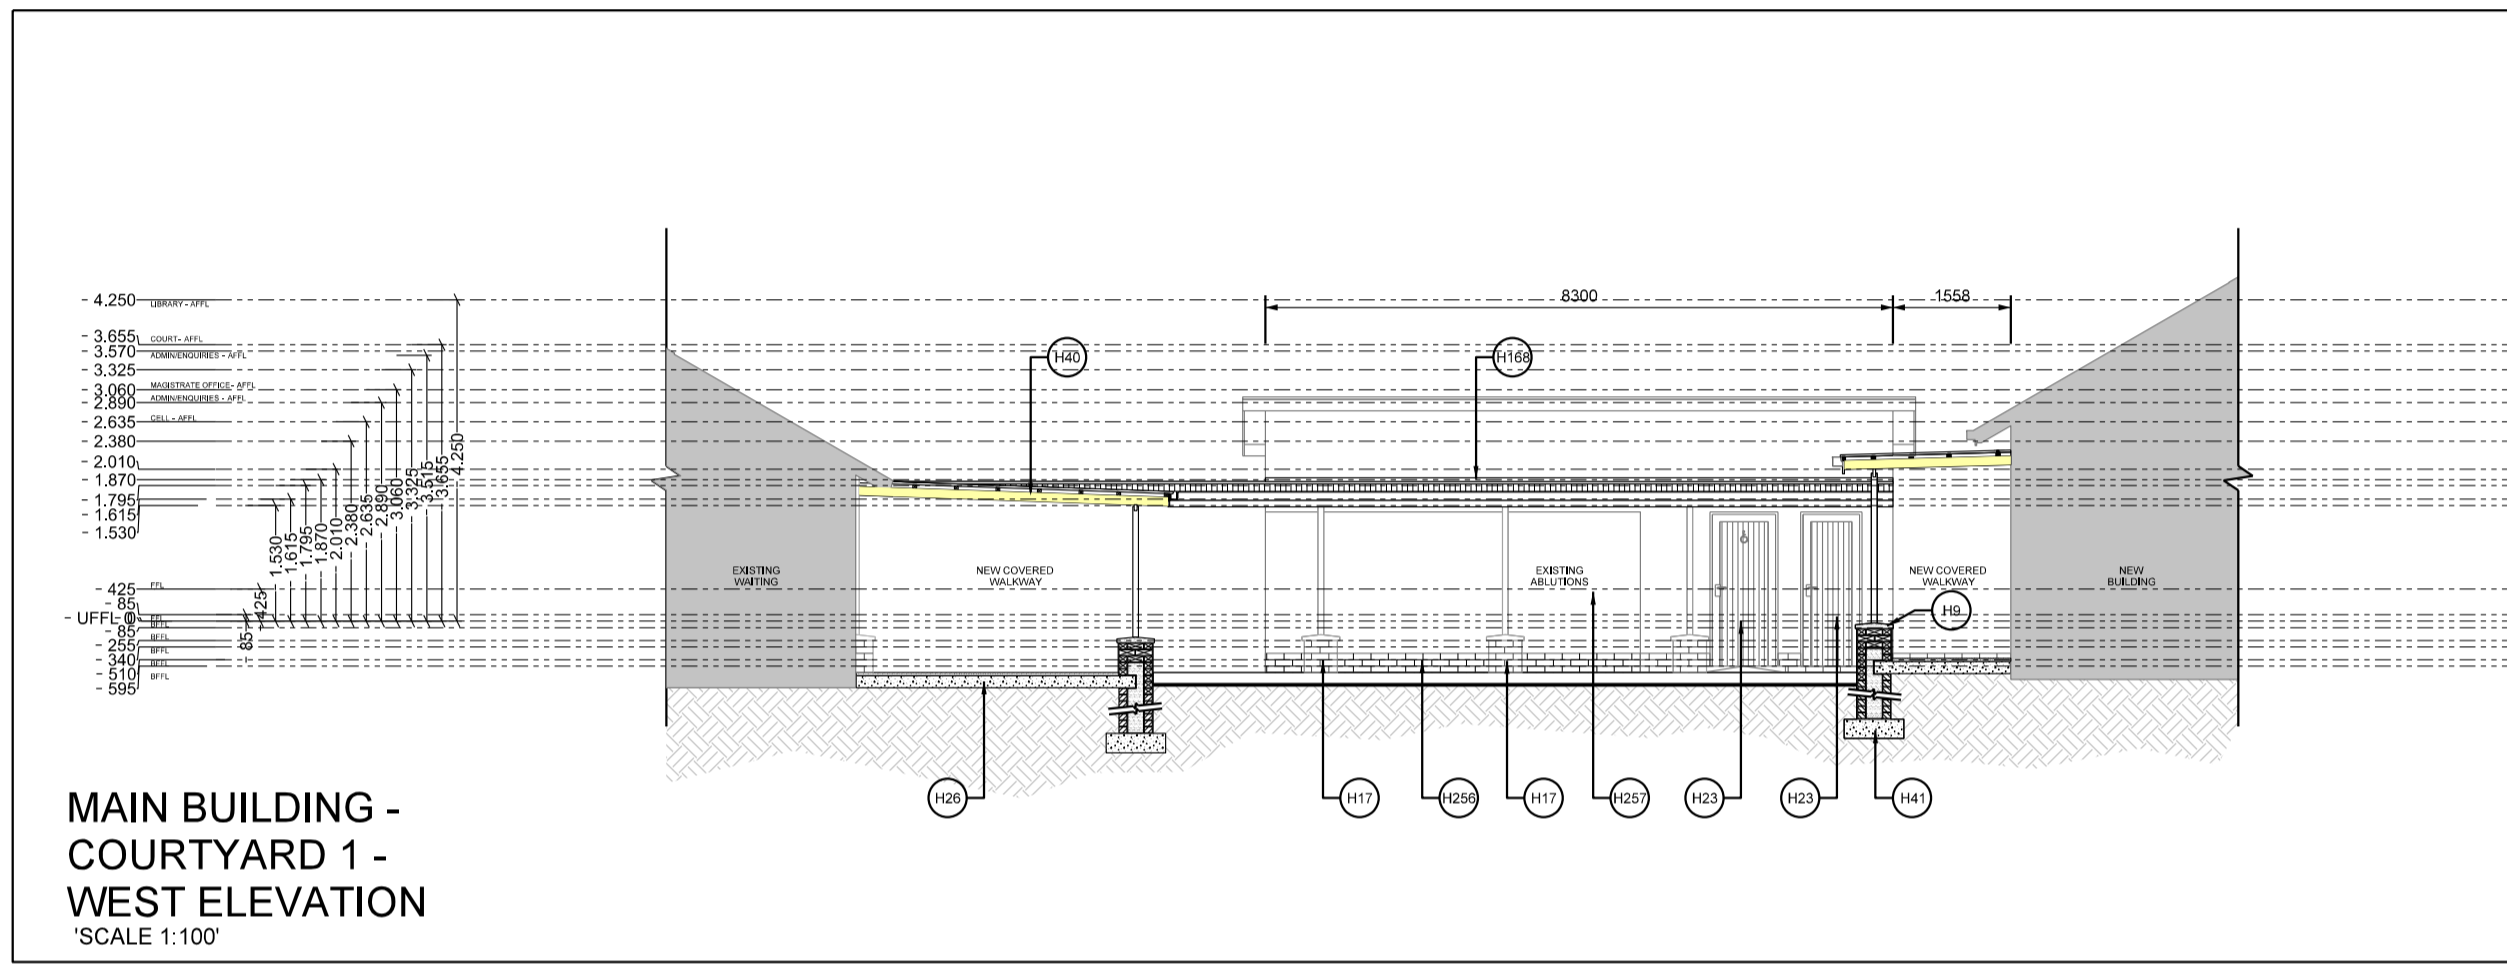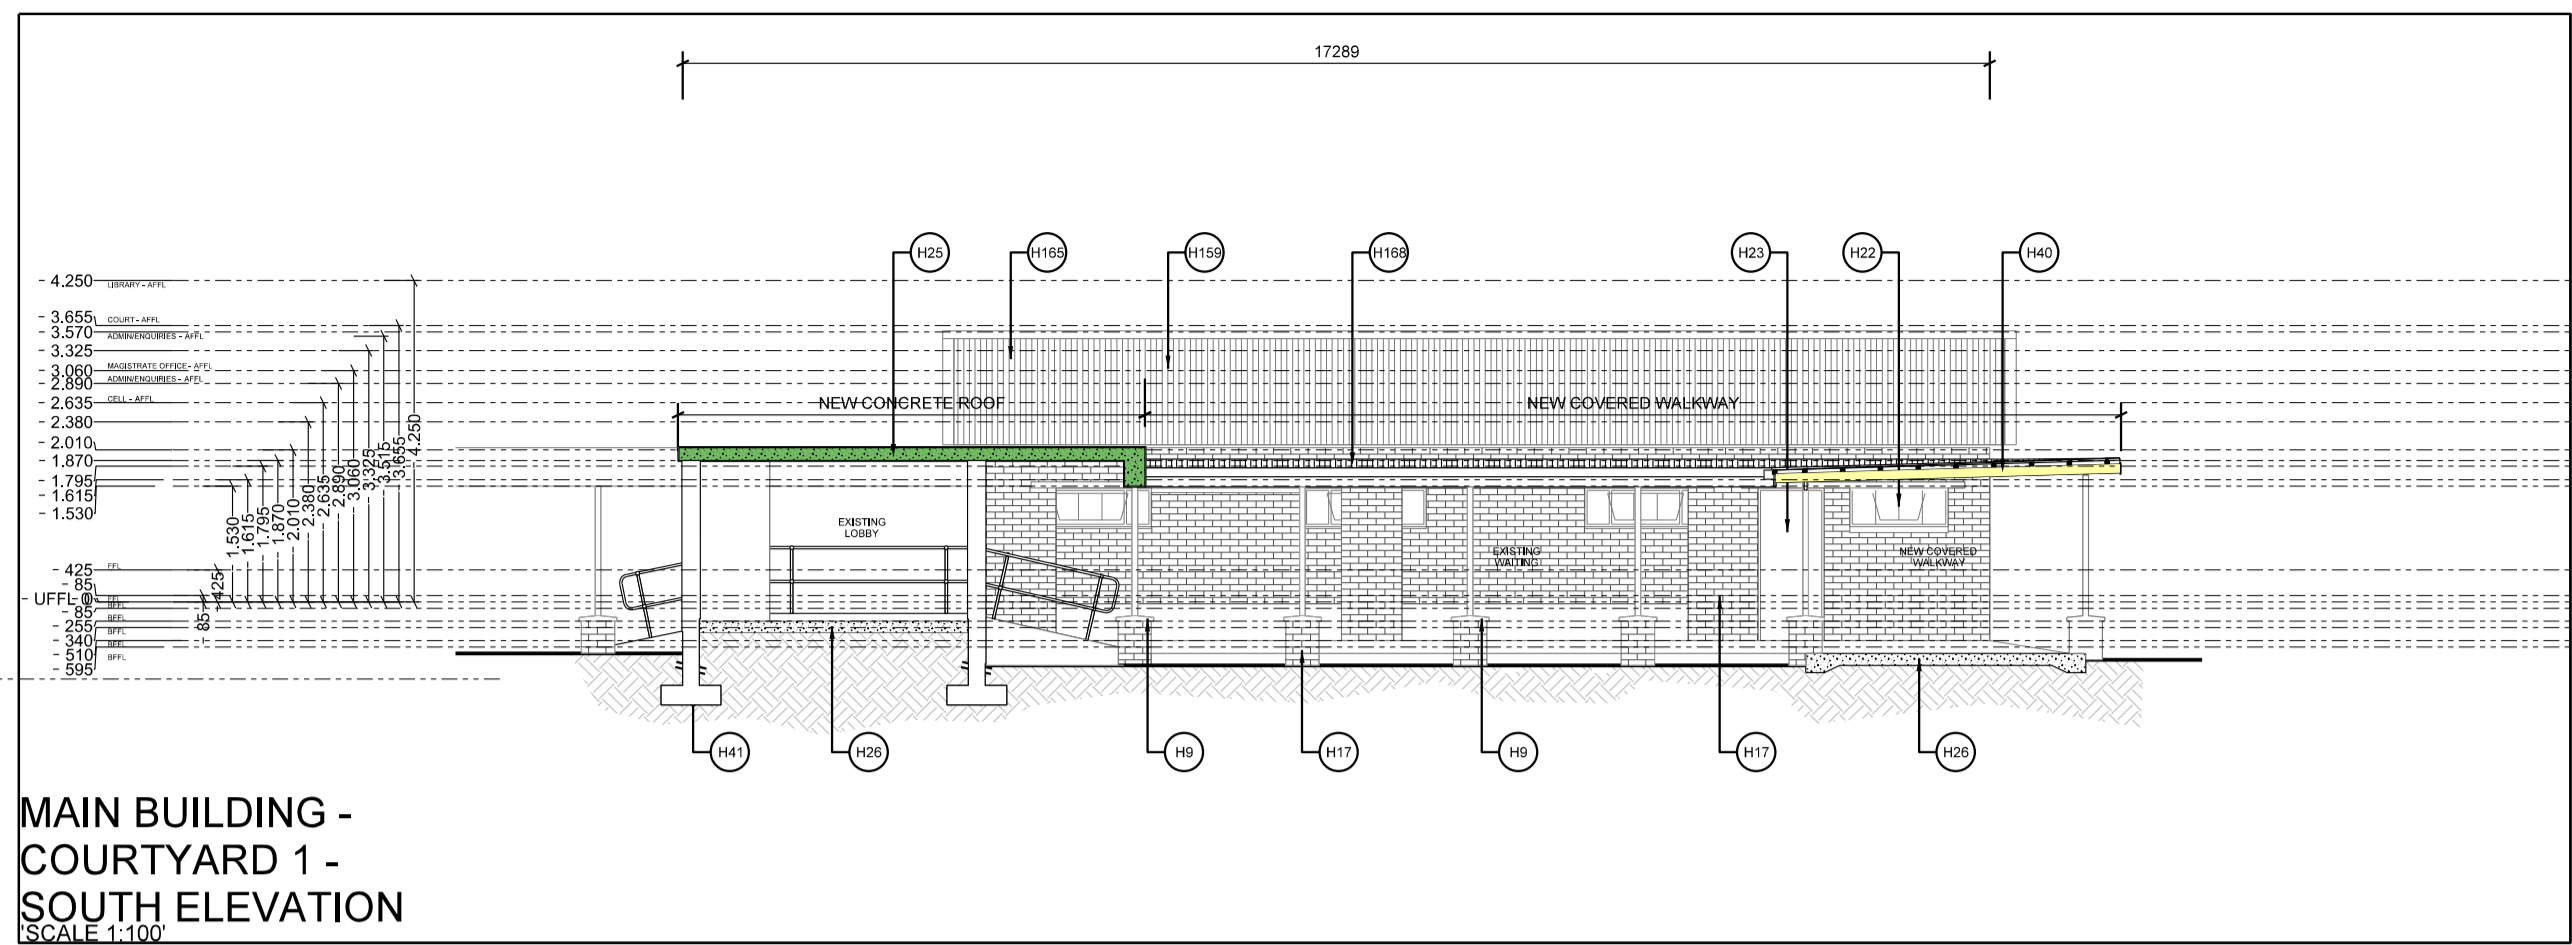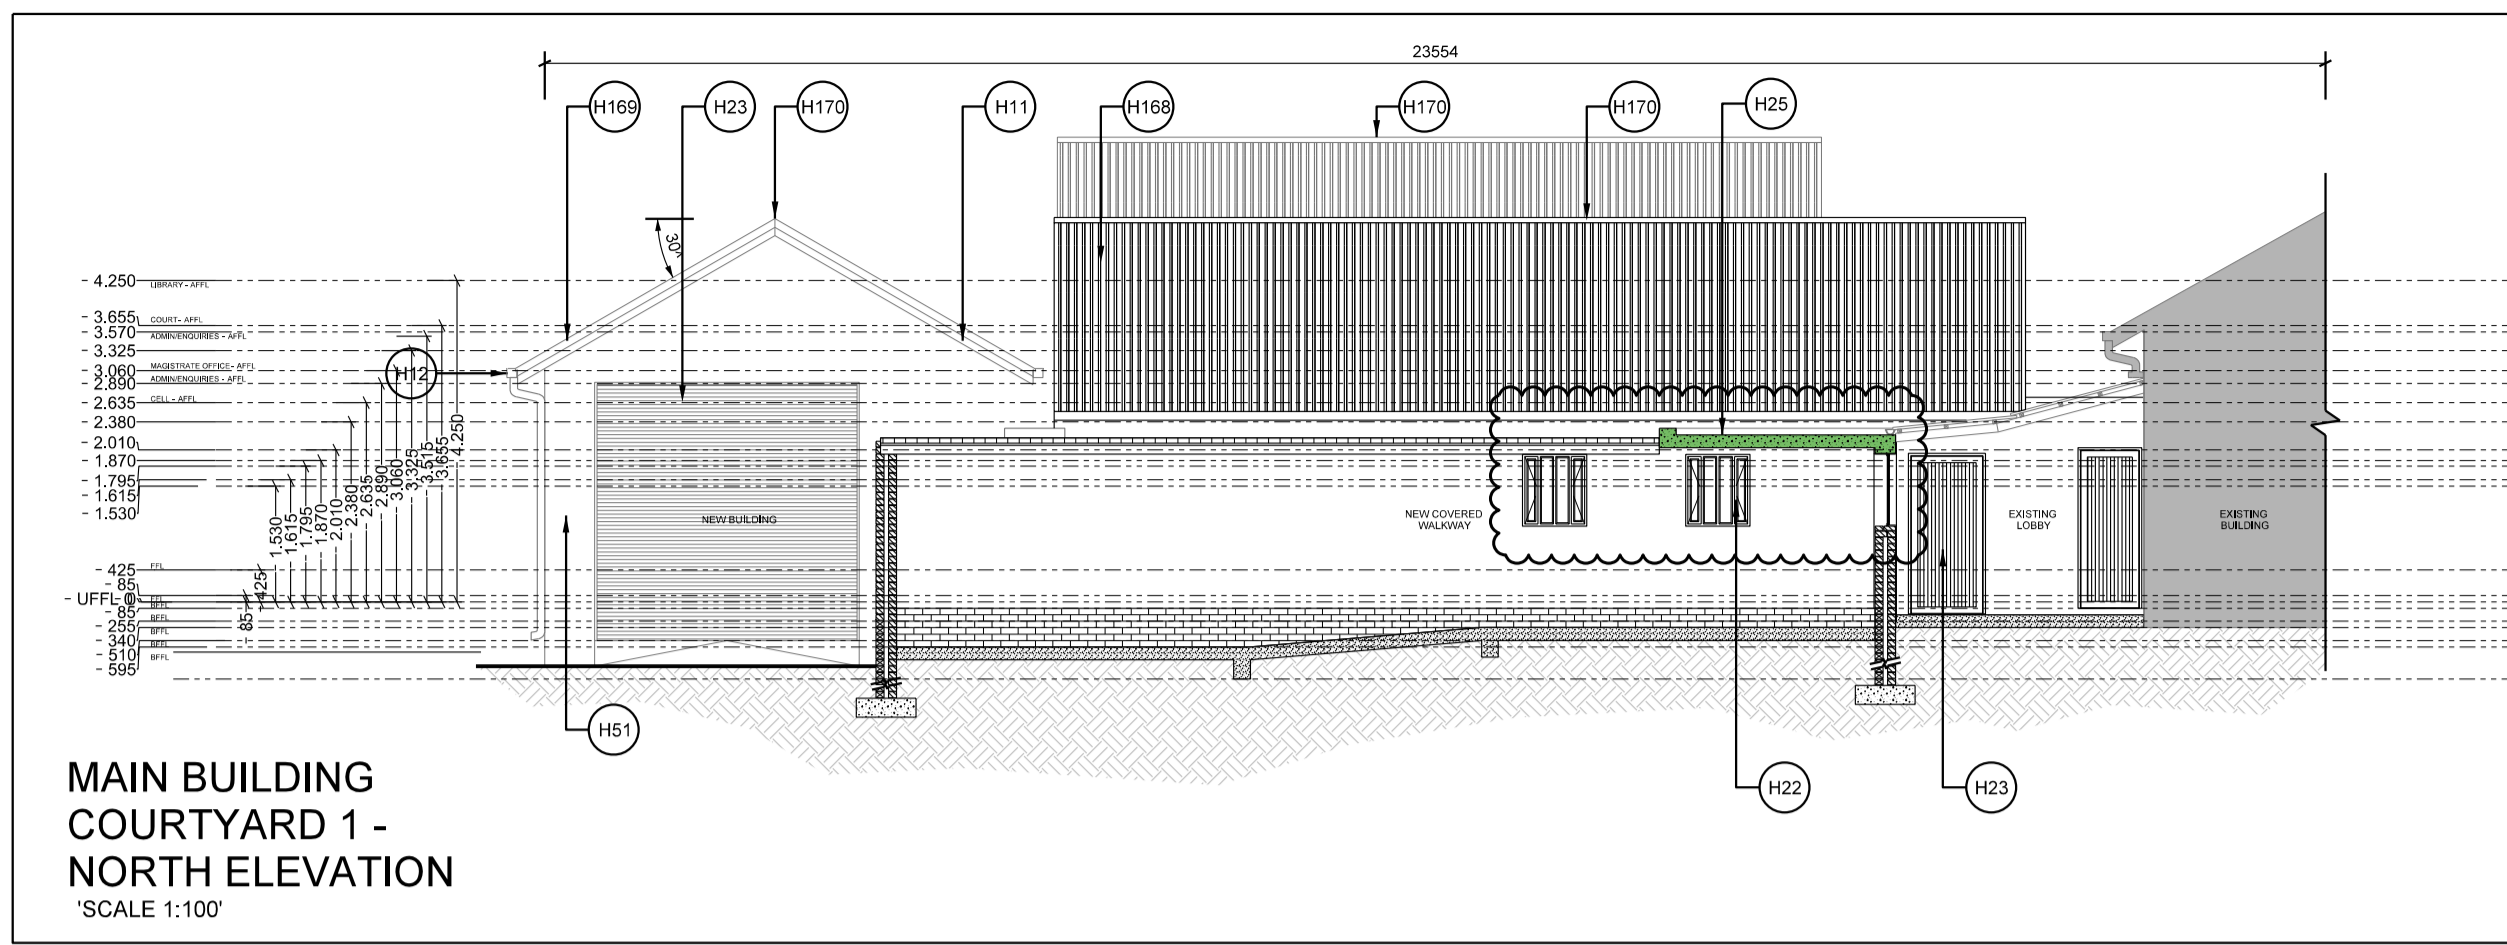


No.	DATE	AMENDMENT	D.P.W.

*R01/ 2014-01-22/ GJP/ Revised FFL height to (-0.510) and adjusted ramp height accordingly in COURTYARD 1 - NORTH ELEVATION
 R02/ 2019/12/17/ BVS/ Dimensions added.
 R03/ 2021-04-09/ BVS/ Revised according to changes on plan and roof plan
 R04/ 2021-04-16/ BVS/ Revised H-notes
 R04/ 2021-04-22/ BVS/ Revised to include revised prison type windows.

ELEVATIONS LEGEND	
	- EXISTING SHEET METAL ROOF
	- NEW SHEET METAL ROOF
	- FACEBRICK
	- SMOOTH PLASTER

Copyright vests in the Department of Public Works
 as-built drawings
 certified as-built drawings as per Centralised Drawing Archive AS-BUILT DRAWING REQUIREMENTS
 name: _____
 date: _____
 professional registration no.: _____

cad file name: 25500-030-002 page type: A 1

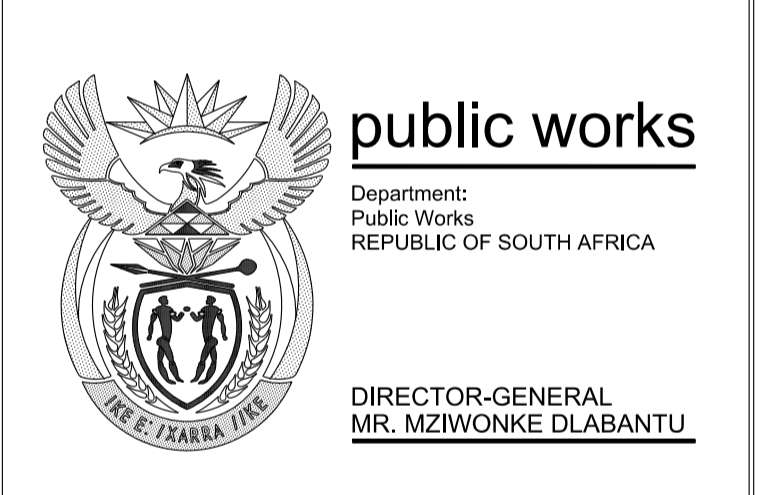

consultant: Bartsch
 BARTSCH CONSULT (Pty) Ltd
 REG. NO. CK 903199523
 HARRISMITH: TEL(051) 5223471, P.O.BOX 762, HARRISMITH 9690
 QUEENSTOWN: TEL(045) 839 5728, LADYSMITH: TEL(036) 631 1888
 EAST LONDON: TEL(043) 727 0765, BLOEMFONTEIN: TEL (051) 300547
 CAPE TOWN: TEL(021) 252225, PRETORIA: TEL(012) 3466526
 WINDHOEK : TEL(0926461) 237403.

discipline: ARCHITECT

service: _____

BERGVILLE JUSTICE - COMPLETE UPGRADING INCLUDING R & R

WCS number: WCS 036745

drawing title: "COURTYARD 1 - ELEVATIONS; COURTYARD 2 - ELEVATIONS; WAITING - ELEVATIONS; ABLUTION - ELEVATIONS"

ref.no.: _____ designed: _____
 scale: 1:100 drawn: BVS
 date: 22-Apr-21 checked: _____

DPW drawing number: 25500-030-002 R04 22-Apr-21

